IREDELL COUNTY HEALTH DEPARTMENT

STATESVILLE 704-878-5305 MOORESVILLE 704-664-5281

Paid 125.00 2100

IMPROVEMENT PERMIT / AUTHORIZATION TO CONSTRUCT / OPERATION PERMIT / EXISTING SYSTEM INSPECTION

PERMIT# 093310 PIN# 4636889893 DATE 1/24/02

OWNER OR CONTRACTOR GO SMITH DEVELOPMENT PHONE: Business 892-0909 Home

ADDRESS PO Box 908 DAVIDSON NC 28031

LOCATION BRAWLEY SCHOOL - TL CANVASBACK - TL REGENCY - TR HIGHTOWER 3RD ON CT

SUBDIVISION REGENCY LAKE BLOCK / SECTION F LOT 18 LOT AREA .45AC SITE CLASS. RS DESIGN FLOW 360GPD L.T.A.R. .30PD/FT²

Septic Tank: 1000 Gallons; STB 312 Date 6-10-02
Pump Tank: 1000 Gallons; PT 27 Date 8-30-02
Pump Make: Myers Model ME3F Serial No.
Nitrification Field: No Fields 1 Square Feet 400 Linear Feet 200
No Lines 4@50' Trench Width 24" Max Trench Bottom Depth 36" Gravel Depth N/A


☑ New System ☐ Repair System Type: I, II, III, IV, V, VI
System Description: PUMP PANEL
Repair System Description: DEEDED B-4 1983-UP PANEL
Maintenance Agreement Required: ☐ Yes ☑ No

☑ House/Mod. Home No. Bedrooms 3
☐ Mobile Home No. Bathrooms 3
☐ Business No. Employees
☐ Other
☐ Slab ☑ Crawl Space ☐ Basement w/plumbing ☐ Basement wo/plumbing

Water Supply: ☐ Individual ☐ Public ☑ Community

Comments/Conditions: 1) SIDEWALLS OF TRENCHES TO BE RAKED BEFORE PANELS ARE INSTALLED. AND LINED
Checked tanks & lines 6/4/2002

INITIAL SITE SKETCH 1"=50'

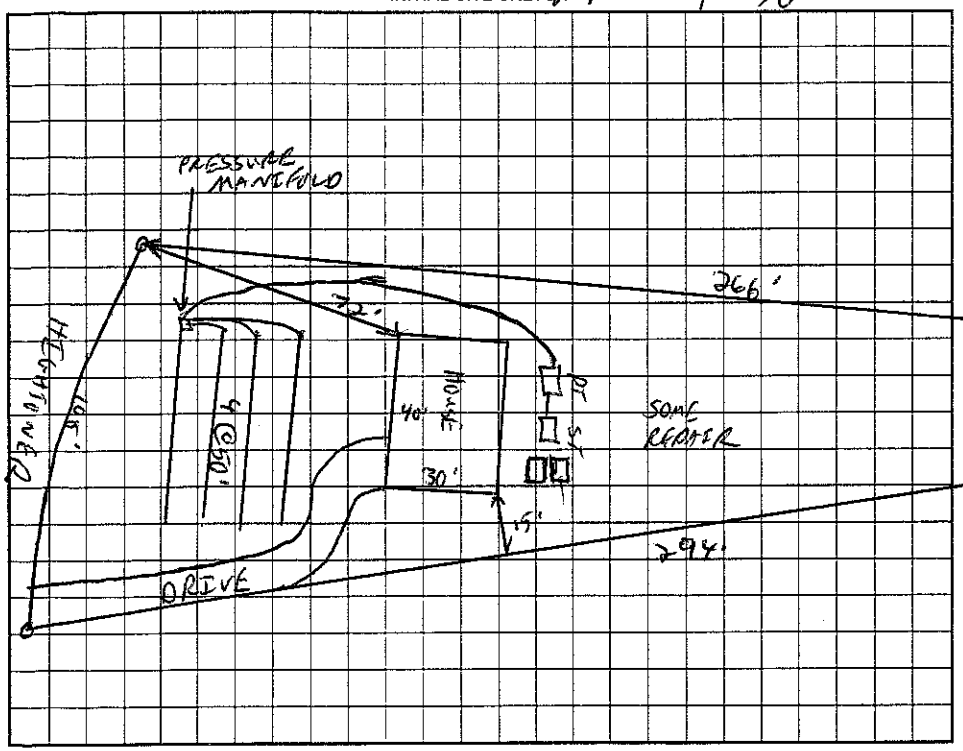

Comments/Conditions: Note: Temporary drive was crossing drainfield/area. Builder knows drive must hug property line & NOT cross drainfield

AS BUILT SKETCH

Pressure elect & alarm 1/9/03
Panel lines installed as Drawn.

Permit can be suspended or revoked if any false information is supplied toward securing the permit/any unauthorized changes are made to the site/any unauthorized changes are made in the installation of the system. Improvement Permit with plat valid without expiration. Improvement Permit with site plan valid for sixty months. Authorization to Construct is valid for a period equal to that of Improvement Permit - not to exceed sixty months.

Signed: date 1-29-02 Installed by: R & H Inc.

Improvement Permit by: RS date 1/24/02 Operation Permit by: RS date 1/8/03

Authorization to Construct by: RS date 6/12/02 Existing System Inspection by: date

HEALTH DEPT. COPY: WHITE OWNER COPY (FINAL): YELLOW OWNER COPY (INITIAL): PINK