IREDELL COUNTY HEALTH DEPARTMENT

STATESVILLE 704-878-5305 MOORESVILLE 704-664-5281

IMPROVEMENT PERMIT / AUTHORIZATION TO CONSTRUCT / OPERATION PERMIT / EXISTING SYSTEM INSPECTIO

125.00 Paid 1030

PERMIT# 093311 PIN# 4636889980 DATE 1/24/02

OWNER OR CONTRACTOR GD SMITH DEVELOPMENT PHONE: Business 892-0909 Home

ADDRESS PO BOX 908 DAVIDSON NC 28031 111 Hightower

LOCATION BRAWLEY SCHOOL - TL CANVASBACK - TL REGENCY - TR HIGHTOWER - 2nd ON LT

SUBDIVISION REGENCY LAKE BLOCK / SECTION F LOT 19 LOT AREA .3AC SITE CLASS. PS DESIGN FLOW 360GPD L.T.A.R. .36PD/FT²

Septic Tank: 1000 Gallons; STB 312 Date 4/15/02
Pump Tank: 1000 Gallons; PT 283 Date 8/24/02
Pump Make: ME3F Model Serial No.
Nitrification Field: No Fields 1 Square Feet 400 Linear Feet 200
No Lines 4@50' Trench Width 24" Max Trench Bottom Depth 36" Gravel Depth N/A

☑ New System ☐ Repair System Type: I, II, III, IV, V, VI
System Description: PUMP PANEL
Repair System Description: LP PANEL
Maintenance Agreement Required: ☐ Yes ☑ No

☑ House/Mod. Home No. Bedrooms 3
☐ Mobile Home No. Bathrooms 3
☐ Business No. Employees
☐ Other


☐ Slab ☑ Crawl Space ☐ Basement w/plumbing ☐ Basement wo/plumbing

Water Supply: ☐ Individual ☐ Public ☑ Community

Comments:/Conditions:

Comments:/Conditions: Lines Checked & Tanks Checked 10/9/2002
Pressure, elect & alarm 1/22/03

INITIAL SITE SKETCH 1"=50'

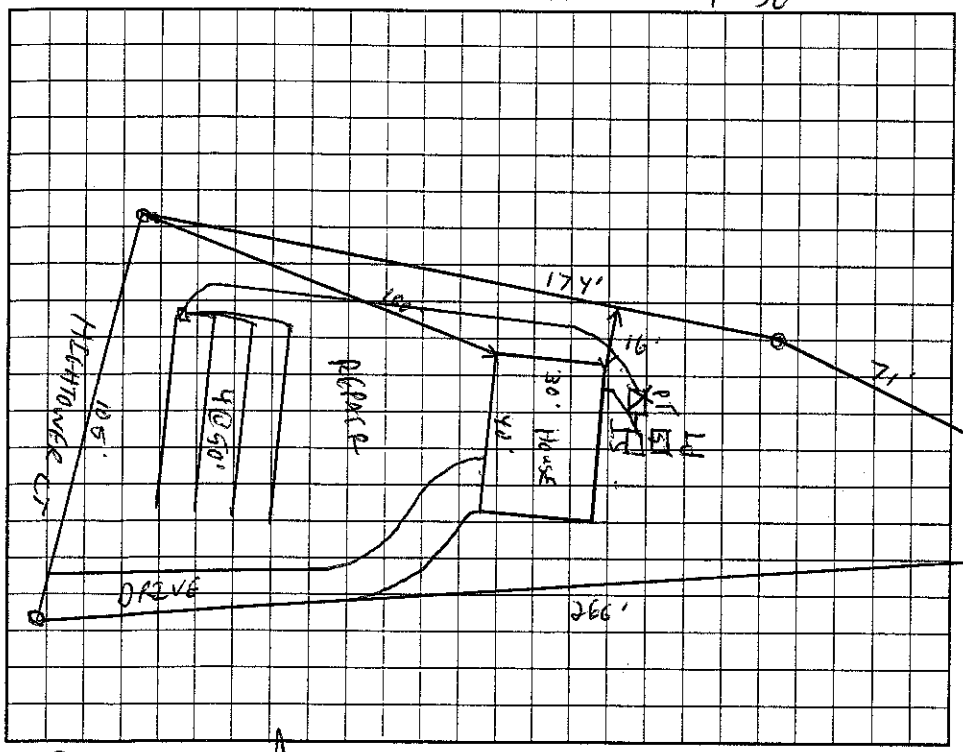

AS BUILT SKETCH

Installed as Drawn

Permit can be suspended or revoked if any false information is supplied toward securing the permit/any unauthorized changes are made to the site/any unauthorized changes are made in the installation of the system. Improvement Permit with plat valid without expiration. Improvement Permit with site plan valid for sixty months. Authorization to Construct is valid for a period equal to that of Improvement Permit – not to exceed sixty months.

Signed: date 1/29/02 Installed by: R & H Inc RS

Improvement Permit by: RS date 1/24/02 Operation Permit by: Maria Hill Watson date 1/22/03

Authorization to Construct by: RS date 6/12/02 Existing System Inspection by: date

HEALTH DEPT. COPY: WHITE OWNER COPY (FINAL): YELLOW OWNER COPY (INITIAL): PINK