IREDELL COUNTY HEALTH DEPARTMENT

STATESVILLE 704-878-5305 MOORESVILLE 704-664-5281 3B

IMPROVEMENT PERMIT / CERTIFICATE OF COMPLETION / OPERATION PERMIT / EXISTING SYSTEM INSPECTION

PROPERTY DESCRIPTION NO. 20623 DATE 1/17/96 TAX MAP NO. 2K 10 B12 4636 89 1075 Watershed: ☐ Yes ☒ No

OWNER OR CONTRACTOR Paul H. Duke III PHONE: Business 596-5264 Home

ADDRESS 9520 Point O Woods Dr. Charlotte NC. 28216

LOCATION Conover Creek TL off Bowley Sch. Rd. (R) on Fantasy Ln. 3rd lot on (R)

SUBDIVISION Josh Acres BLOCK / SECTION LOT 12 LOT AREA ~40,000 FT² SITE CLASS. PS DESIGN FLOW 480 L.T.A.R. .3

Septic Tank: 1000 Gallons; STB 97 Date 11/2/95

Pump Tank: 1000 Gallons; PT 27 Date 10/23/95

Pump Make: Model Serial No.

Nitrification Field: No Fields 1 Square Feet 1600 Linear Feet 533

No Lines 4 Trench Width 36" Max Trench Bottom Depth 36" Gravel Depth 12"

☒ New System ☐ Repair System Type: I. II. (III) IV. V. VI

System Description: Pres - Conventional

Repair Sysiem Description: None

Maintenance Agreement Required: ☒ Yes ☐ No 5 YR.

☒ House/Mod. Home No. Bedrooms 4

☐ Mobile Home No. Bathrooms 3

☐ Business No. Employees

☐ Other


☐ Slab ☒ Crawl Space ☐ Basement w/plumbing ☐ Basement wo/plumbing

Water Supply:
☒ Individual
☐ Community
☐ Public


Comments:

Comments: 12/22/95 Drainlines inspected and approved
1/17/96 Pump, Piping, and Distribution approved

~~INITIAL SITE SKETCH~~ AS BUILT SKETCH

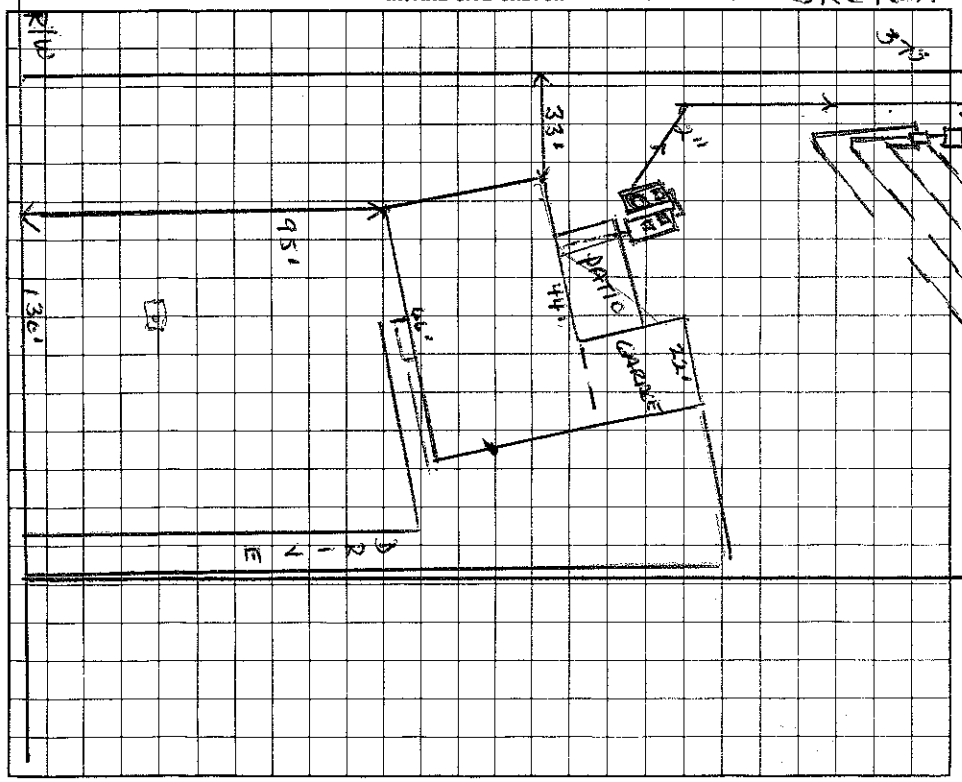

AS BUILT SKETCH

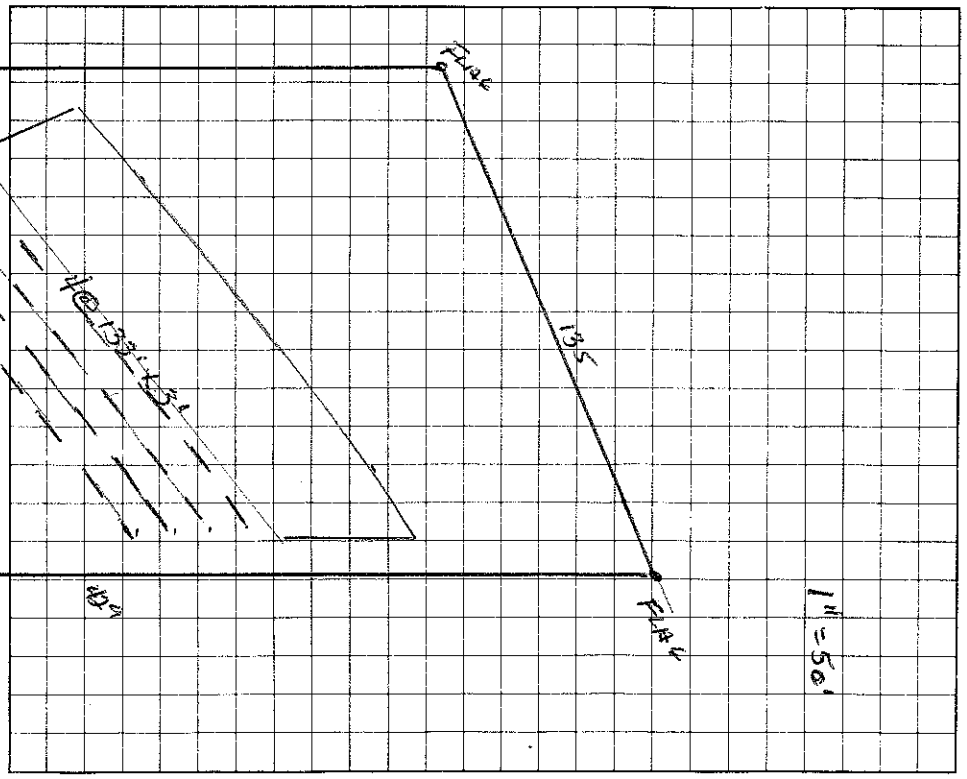

I understand that this permit can be suspended or revoked if any false information is supplied toward securing the permit/any unauthorized changes are made to the site/any unauthorized changes are made in the installation of the system.

Signed:

Improvement Permit by: date

Existing System Inspection by: date

Installed by: Howell Grading

Certificate of Completion by: Wesley Sparks RS date 1/24/96

Operation Permit by: Wesley Sparks RS. date 1/24/96

HEALTH DEPT. COPY: WHITE INSPECTION COPY (FINAL): GREEN OWNER COPY (FINAL): YELLOW INSPECTION COPY (INITIAL): PINK OWNER COPY (INITIAL): GOLD