IREDELL COUNTY HEALTH DEPARTMENT

STATESVILLE 704-878-5305 MOORESVILLE 704-664-5281

IMPROVEMENT PERMIT / CERTIFICATE OF COMPLETION / OPERATION PERMIT / EXISTING SYSTEM INSPECTION

PROPERTY DESCRIPTION NO. 20623 DATE 3/27/95 TAX MAP NO. 2K-10-B-12 Watershed: ☐ Yes ☒ No

OWNER OR CONTRACTOR Paul H. Dale III PHONE: Business 596-5264 Home

ADDRESS 9522 Point O Woods Dr. 28216

LOCATION Conway Creek off Brantley School Rd. (L) on Conway Creek (R) on Fontana Ln. to 3rd house on (R)

SUBDIVISION Josh Acres BLOCK / SECTION LOT 12 LOT AREA ~40,000 sq ft SITE CLASS. A DESIGN FLOW 480 L.T.A.R. .3

Septic Tank: 1000 Gallons; STB 97 Date 11/3/95

Pump Tank: WEC Gallons; PT 37 Date 11/3/95

Pump Make: Model Serial No.

Nitrification Field: No Fields 1 Square Feet 1600 Linear Feet 533

No Lines 4 Trench Width 36" Max Trench Bottom Depth 36" Gravel Depth 12"

☒ New System ☐ Repair System Type: I, II, (III), IV, V, VI

System Description: CONV - DIST. BOX

Repair System Description: CONV - DISTBOX -

Maintenance Agreement Required: ☐ Yes ☒ No

☒ House/Mod. Home No. Bedrooms 4

☐ Mobile Home No. Bathrooms 3

☐ Business No. Employees

☐ Other


☐ Slab ☒ Crawl Space ☐ Basement w/plumbing ☐ Basement wo/plumbing

Water Supply: ☒ Individual ☐ Community ☐ Public


Comments: Follow contours shown here - Repair area as shown here. Terrace should be maintained for surface water diversion.

Comments:

INITIAL SITE SKETCH

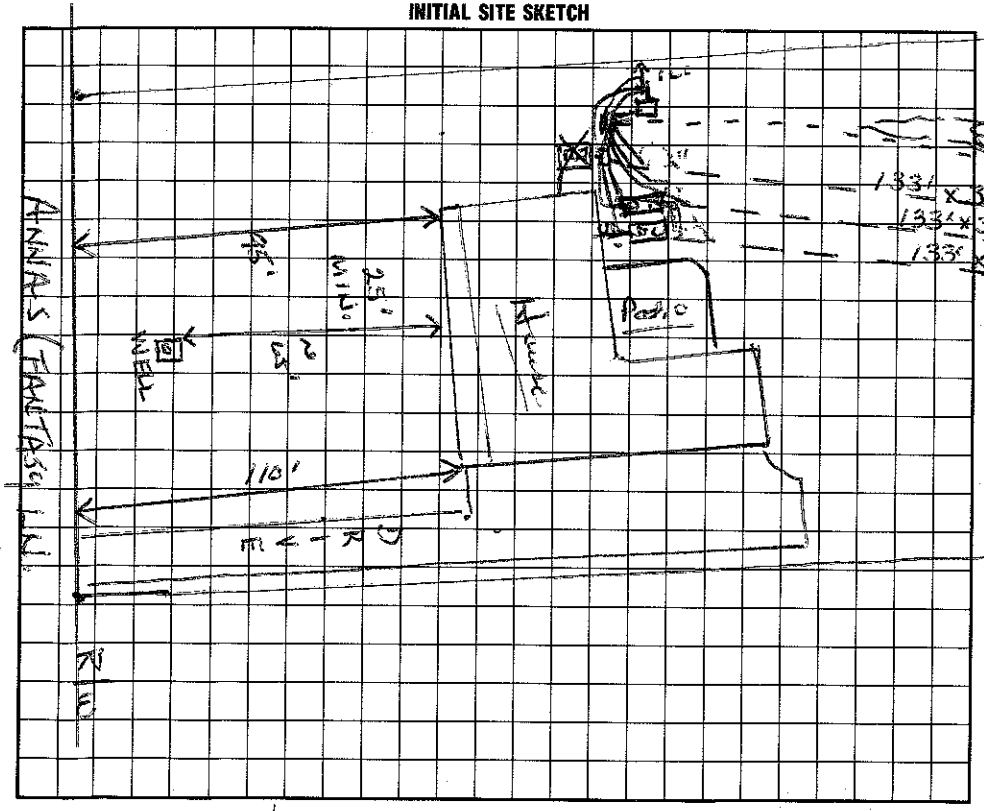

AS BUILT SKETCH

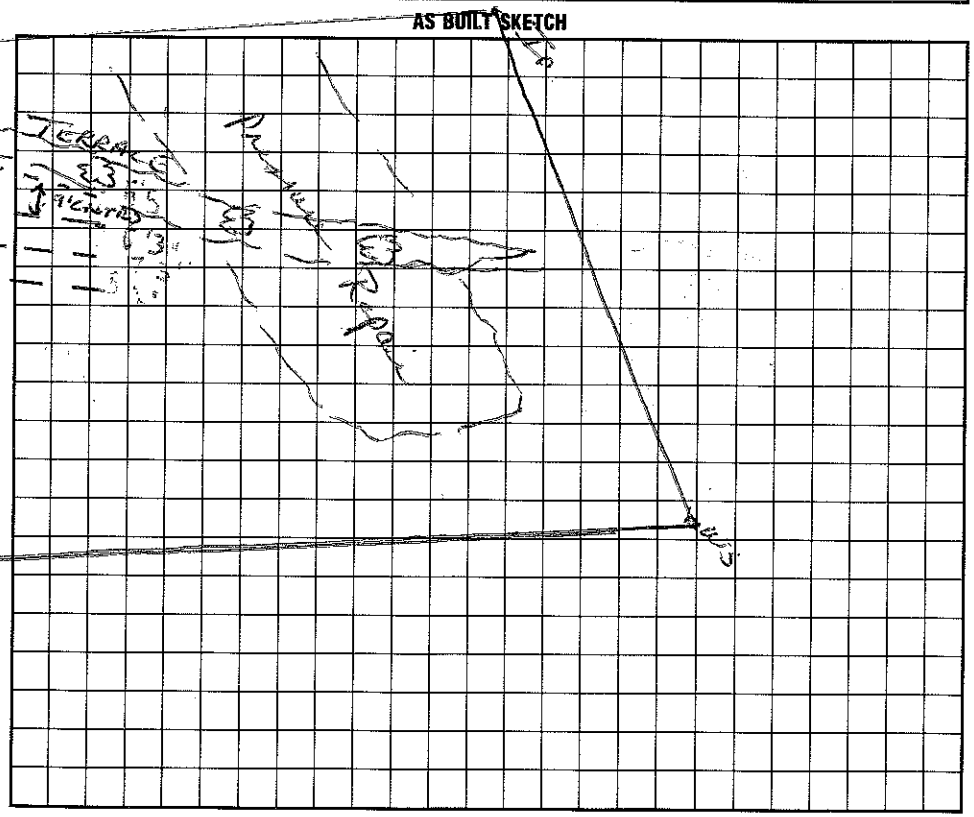

I understand that this permit can be suspended or revoked if any false information is supplied toward securing the permit/any unauthorized changes are made to the site/any unauthorized changes are made in the installation of the system. Improvement Permit is valid for 60 months from date of issuance.

Signed: X

Improvement Permit by: Wesley Sparks R.S. date 3/27/95

Existing System Inspection by: date

Installed by: Howell Septic Tank Co.

Certificate of Completion by: date

Operation Permit by: date

HEALTH DEPT. COPY: WHITE INSPECTION COPY (FINAL): GREEN OWNER COPY (FINAL): YELLOW INSPECTION COPY (INITIAL): PINK OWNER COPY (INITIAL): GOLD