IREDELL COUNTY HEALTH DEPARTMENT

STATESVILLE 704-878-5305 130.00 Paid MOORESVILLE 704-664-5281

IMPROVEMENT PERMIT / AUTHORIZATION TO CONSTRUCT / OPERATION PERMIT / EXISTING SYSTEM INSPECT.

PERMIT# 125147 PIN# 4636893200 4636-89-2230 Wesley DATE 1-21-05

OWNER OR CONTRACTOR Don Vernon / Daniel Zdrfnton PHONE: Business 658-5106 Home

ADDRESS 403 2nd St Sunset Beach, NC 28468

LOCATION Brawley School Rd TL 5 Canvasback on right

SUBDIVISION Josh Acres BLOCK / SECTION LOT 15 LOT AREA .69 Acres SITE CLASS. PS DESIGN FLOW 480gpd L.T.A.R. .3

Septic Tank: 1000 Gallons; STB 825 Date 5-10-05 ☒ New System ☐ Repair System Type: I, II, III, IV, V, VI

Pump Tank: 1000 Gallons; PT 302 Date 5-20-05 System Description: Pump - 25% Reduction

Pump Make: Zoeller Model N98 Serial No. Repair System Description: Pump - Panel Block

Nitrification Field: No Fields 1 Square Feet 1200' Linear Feet 400' Maintenance Agreement Required: ☐ Yes ☒ No

No Lines 4 @ 100' Trench Width 36" Max Trench Bottom Depth 36" Gravel Depth N/A

☒ House/Mod. Home No. Bedrooms 4 ☐ Mobile Home No. Bathrooms 3 ☐ Business No. Employees ☐ Other


☐ Slab ☒ Crawl Space ☐ Basement w/plumbing ☐ Basement wo/plumbing

Water Supply: ☒ Individual ☐ Public ☐ Community


Comments:/Conditions: Feather off old farm berms. Keep Septic System at least 10' From PL & 50-100' to well. Must have 30" Compacted Soil over supply line under driveway. Scale 1:40

Comments:/Conditions: Checked tanks, lines & pressure 8/3/05 Installed Quick 4 Plastic Chambers (also installed "Dissipater" in lines)

INITIAL SITE SKETCH

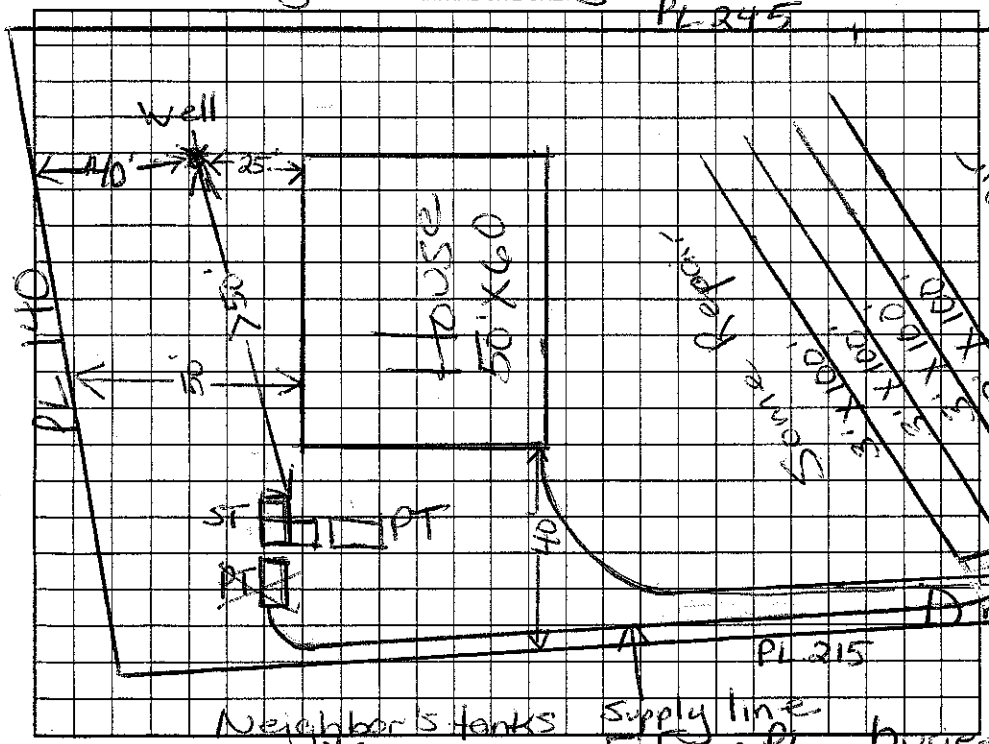

AS BUILT SKETCH

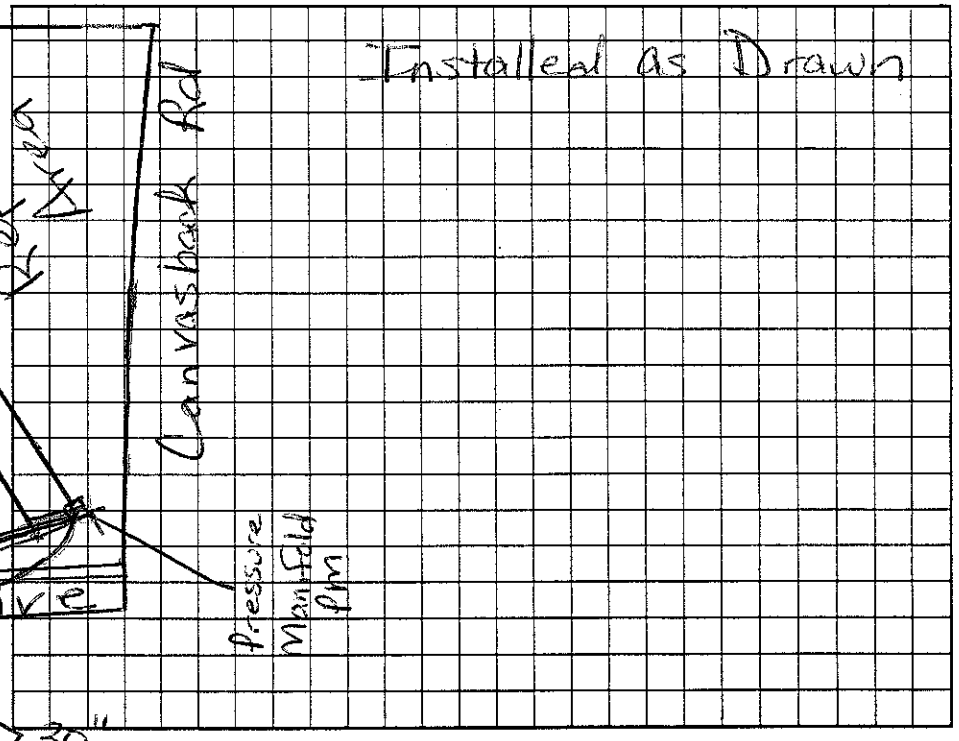

Permit can be suspended or revoked if any false information is supplied toward securing the permit/any unauthorized changes are made to the site/any unauthorized changes are made in the installation of the system. Improvement Permit with plat valid without expiration. Improvement Permit with site plan valid for sixty months. Authorization to Construct is valid for a period equal to that of Improvement Permit – not to exceed sixty months.

Signed: [signature] date 1/21/05 Installed by: Rowan Septic

Improvement Permit by: [signature] RS date 1/21/05 Operation Permit by: [signature] RS date 8/10/05

Authorization to Construct by: [signature] RS date 1/21/05 Existing System Inspection by: date

HEALTH DEPT. COPY: WHITE OWNER COPY (FINAL): YELLOW OWNER COPY (INITIAL): PINK