IREDELL COUNTY HEALTH DEPARTMENT

PAID #725

STATESVILLE 704-878-5305 MOORESVILLE 704-664-3281

16100

IMPROVEMENT PERMIT / AUTHORIZATION TO CONSTRUCT / OPERATION PERMIT / EXISTING SYSTEM INSPECTION

PERMIT # N/A PIN # ~~4636893048~~ 4636893007 DATE 12-17-08

OWNER or APPLICANT Michael Sullivan PHONE: Business 704 575 4998 Home: Paul P. w/SAME 704 996-6330

OWNER or APPLICANT ADDRESS 183 Crystal Circle Mooresville, NC 28117

LOCATION / DIRECTIONS Brawley School Rd TL Canvasback on right before Fantasy Ln #132

SUBDIVISION Josh Acres BLOCK / SECTION LOT # 14 LOT AREA .55Acres DESIGN FLOW 480gpd L.T.A.R. .3

Part of Initial Drainfield Test to NCDOT Construction

Septic Tank	Exist 1000	Gallons: STB		Date		☐ New System ☐ Repair ☒ Expansion System Type I II III (IV) V VI	☒ Residence	No. Bedrooms 4	Water Supply ☒ Private
Pump Tank	1000	Gallons: PT		Date		System Description: Pump-Up-Panel Blk	☐ Business	No. Persons	☐ Public
Pump Make		Model		Serial #		Repair System Description: Same	☐ Other	No. Employees	☐ Community
Nitrification Field	No Fields 1	No Lines 5	Linear Feet 267'			Maintenance Agreement Required ☒ YES ☐ NO	☐ Slab	☐ Crawl Space	
Trench Width	24"	Max. Trench Bottom Depth	36"	Gravel Depth N/A		☐ GRAVITY ☒ PRESSURE	☐ Basement w/plumbing	☐ Basement w/o plumbing	


Comments / Conditions ☒See attached plan by SAME for details

1:30

Comments / Conditions Replace Drainfield lines impacted by DOT expansion

☒Create dip in drive to allow surface runoff to edge of sidewalk. Divert surface water around

INITIAL SITE SKETCH

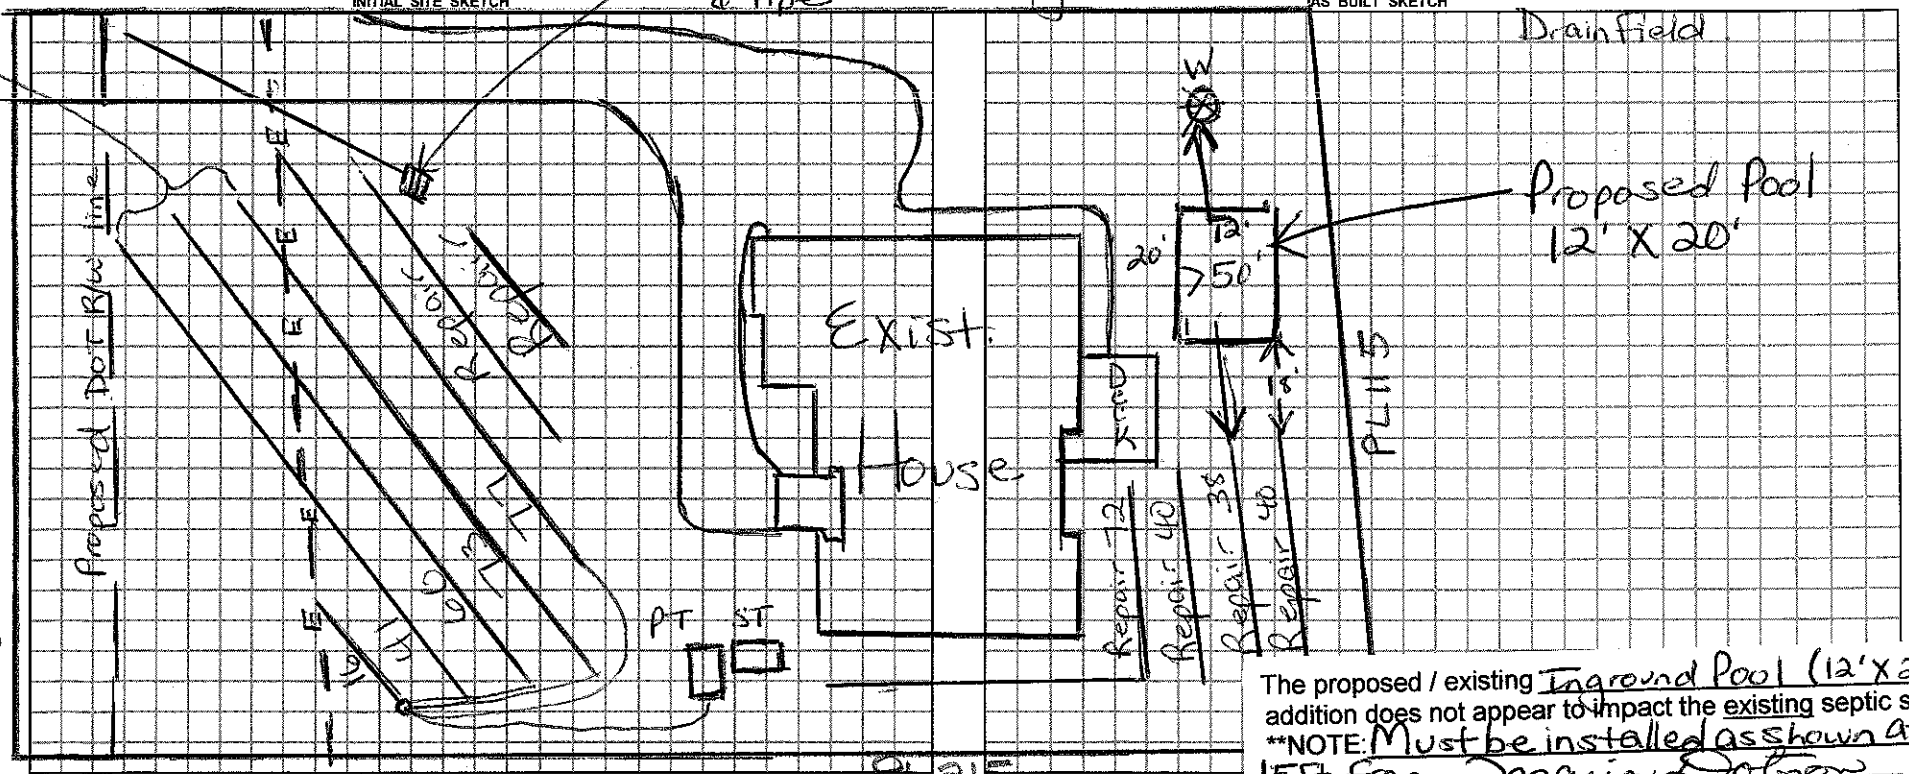

AS BUILT SKETCH

The proposed / existing Inground Pool (12'X20') addition does not appear to impact the existing septic system.

**NOTE: Must be installed as shown at least 15ft from Proposed Repair lines.

Maria Dotson R.S.

Date: 9/5/12

ICHD-Environmental Health Division

Permit can be suspended or revoked if any false information is supplied toward securing the permit / any unauthorized changes are made to the site / any unauthorize

☐ *IMPROVEMENT PERMIT w / plat valid without expiration.* ☐ *IMPROVEMENT PERMIT w / site plan valid for 60 mos.* ☐ *AUTHORIZATION TO C*

Owner / Applicant Signature: [signature] Date 12/27/08

Improvement Permit by: Maria Dotson R.S. Date 12/19/08

Authorization to Construct by: Maria Dotson R.S. Date 12/19/08

YOU SHOULD CONTACT A LOCATOR SERVICE PRIOR TO ANY EXCAVATION.

Installed by: C Wayne Wilson

Operation Permit by: Maria Dotson R.S. Date: 9/5/12

Existing System Inspected by: Date:

WHITE COPY Environmental Health YELLOW COPY (Final) Owner / Applicant PINK COPY (Initial) Owner / App.