IREDELL COUNTY HEALTH DEPARTMENT

STATESVILLE 704-878-5305 MOORESVILLE 704-664-5281

IMPROVEMENT PERMIT / AUTHORIZATION TO CONSTRUCT / OPERATION PERMIT / EXISTING SYSTEM INSPECTION

PERMIT# 092582 PIN# ~~4636895198~~ 4636-89-5187 DATE 11-20-01

OWNER OR CONTRACTOR GD Smith Development PHONE: Business 892-0909 Home Tim 866-9540

ADDRESS P.O. Box 908 Davidson, NC 28031

LOCATION Brawley School Rd Tr Canvasback at corner of Regency

SUBDIVISION Regency Lk BLOCK / SECTION E LOT 15 LOT AREA .41 Acre SITE CLASS. PS DESIGN FLOW 360 gpd L.T.A.R. .3

Septic Tank: 1000 Gallons: STB 794 Date 12-9-01

Pump Tank: _____ Gallons: PT _____ Date _____

Pump Make: _____ Model _____ Serial No. _____

Nitrification Field: No Fields 1 Square Feet 900' Linear Feet 300'

No Lines 5@60' Trench Width 36" Max Trench Bottom Depth 36" Gravel Depth N/A

☒ New System ☐ Repair System Type: I, II, III, IV, V, VI

System Description: Gravity - 25% Reduction

Repair System Description: ~~Same~~ Sand Pump - LP - Panel Blk

Maintenance Agreement Required: ☐ Yes ☒ No

☒ House/Mod. Home ☐ Mobile Home ☐ Business ☐ Other

No. Bedrooms 3 No. Bathrooms 2.5 No. Employees ____

☐ Slab ☒ Crawl Space ☐ Basement w/plumbing ☐ Basement wo/plumbing


Water Supply: ☐ Individual ☒ Public ☒ Community

Comments:/Conditions: Keep Septic System at least 10' from R


Note: Keep house 35' from road

Comments:/Conditions: ☆ Okay to use "drop boxes" instead of Distribution box Installed EZ Flow

INITIAL SITE SKETCH Scale 1:50

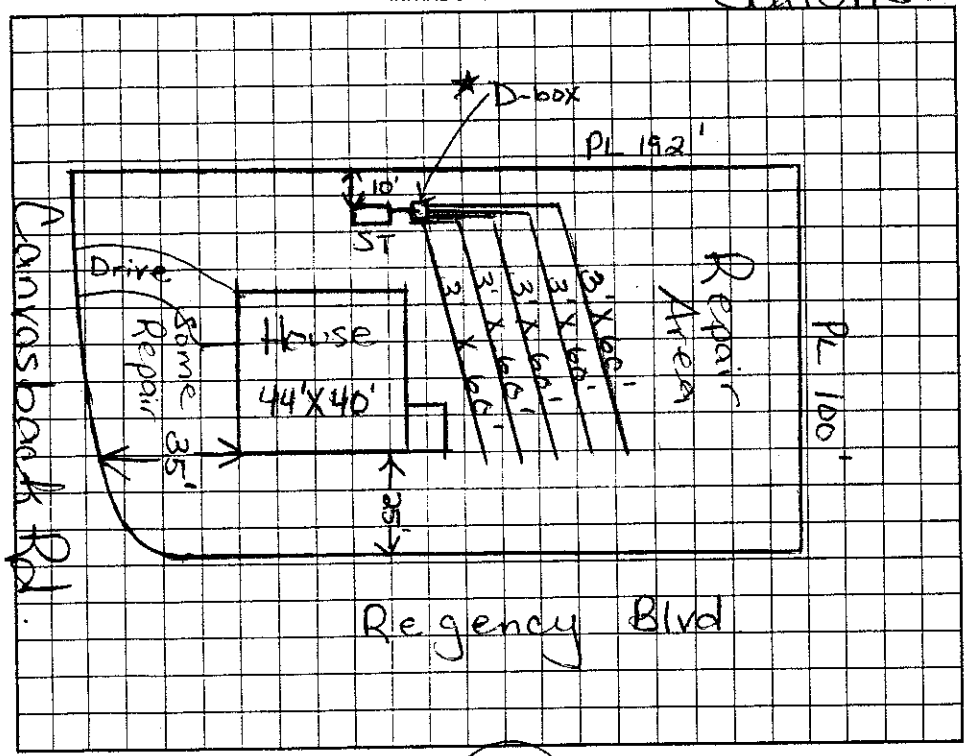

AS BUILT SKETCH

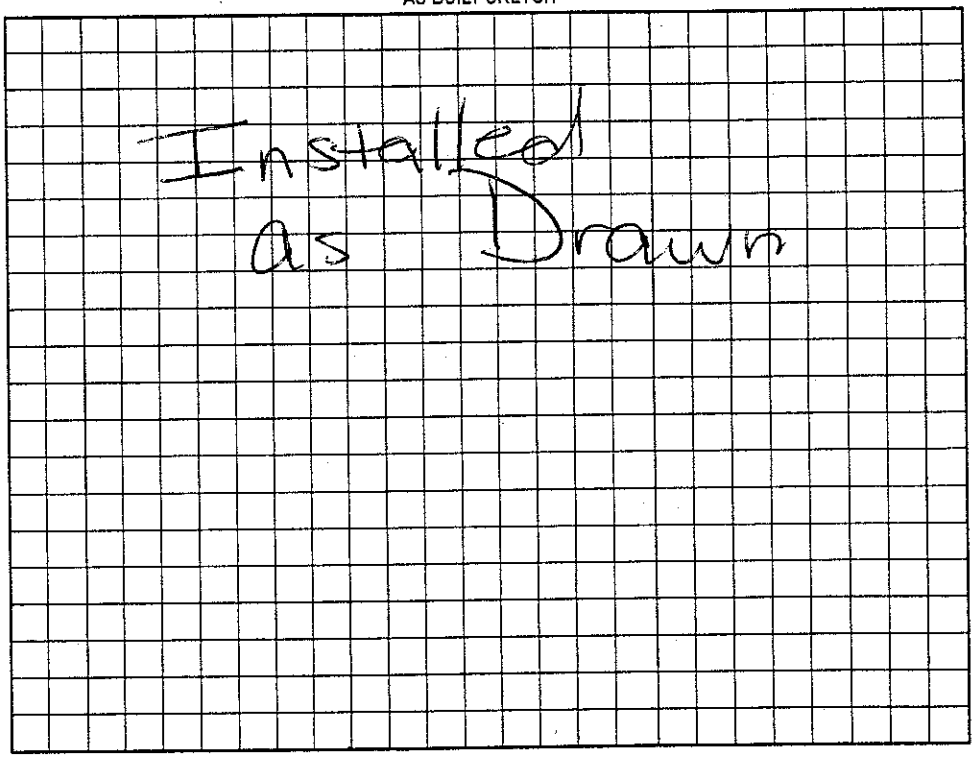

Permit can be suspended or revoked if any false information is supplied toward securing the permit/any unauthorized changes are made to the site/any unauthorized changes are made in the installation of the system. Improvement Permit with plat valid without expiration. Improvement Permit with site plan valid for sixty months. Authorization to Construct is valid for a period equal to that of Improvement Permit – not to exceed sixty months.

Signed: _____ date 11/20/2001 Installed by: R & H Trg RS

Improvement Permit by: Maria H Watson RS date 11/20/2001 Operation Permit by: Maria H Watson date 2/15/2002

Authorization to Construct by: Maria H Watson RS date 11/20/2001 Existing System Inspection by: _____ date _____