IREDELL COUNTY HEALTH DEPARTMENT

STATESVILLE 704-878-5305 330 Paid MOORESVILLE 704-664-5281

IMPROVEMENT PERMIT / AUTHORIZATION TO CONSTRUCT / OPERATION PERMIT / EXISTING SYSTEM INSPECTION

PERMIT# 092584 PIN# 4636-89-5347 DATE

OWNER OR CONTRACTOR Greg Smith Builders PHONE: Business 892-0909 Home 892-0988 Breck

ADDRESS PO Box 908 Davidson NC 28036

LOCATION Brawley Sch, TL Canvasback on Lt before Regency

SUBDIVISION Regency LK BLOCK / SECTION LOT 17 LOT AREA 0.30 Ac SITE CLASS PS DESIGN FLOW 360 L.T.A.R. 0.3

Septic Tank: 1000 Existing Gallons; STB Date

Pump Tank: 1000 Existing Gallons; PT Date

Pump Make: Model Serial No.

Nitrification Field: No Fields 1 Square Feet 400± Linear Feet 200

No Lines 4@50 Trench Width 24"-36" Max Trench Bottom Depth 30" Gravel Depth

☐ New System ☐ Repair System Type: I, II, III, IV, V, VI

System Description: PM Panel Block

Repair System Description: Used Prior to 1983

Maintenance Agreement Required: ☐ Yes ☒ No

☒ House/Mod. Home ☐ Mobile Home ☐ Business ☐ Other

No. Bedrooms 3 No. Bathrooms 2.5 No. Employees


☐ Slab ☒ Crawl Space ☒ Basement w/plumbing ☐ Basement wo/plumbing

Water Supply: ☐ Individual ☐ Public ☒ Community


Comments/Conditions: Panel lines Installed on 3/28/02 were damaged by the installation of the water line. New Panels are to be installed to replace the damaged ones.

Comments/Conditions: Excavated soil needs to be repacked to keep effluent from bleeding between the trenches.

INITIAL SITE SKETCH

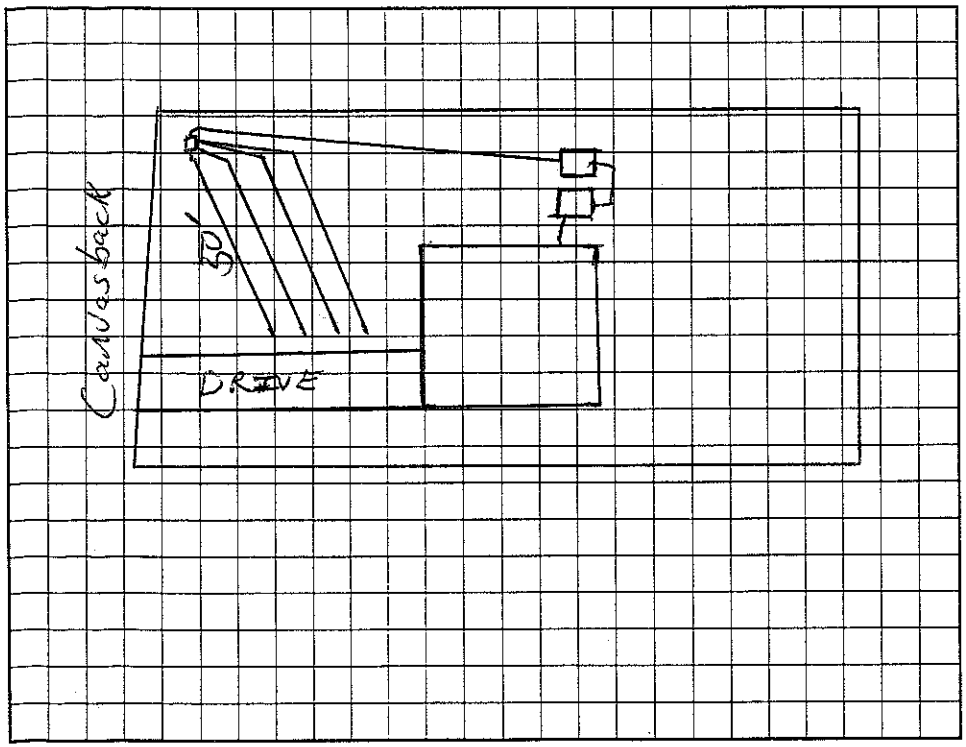

AS BUILT SKETCH

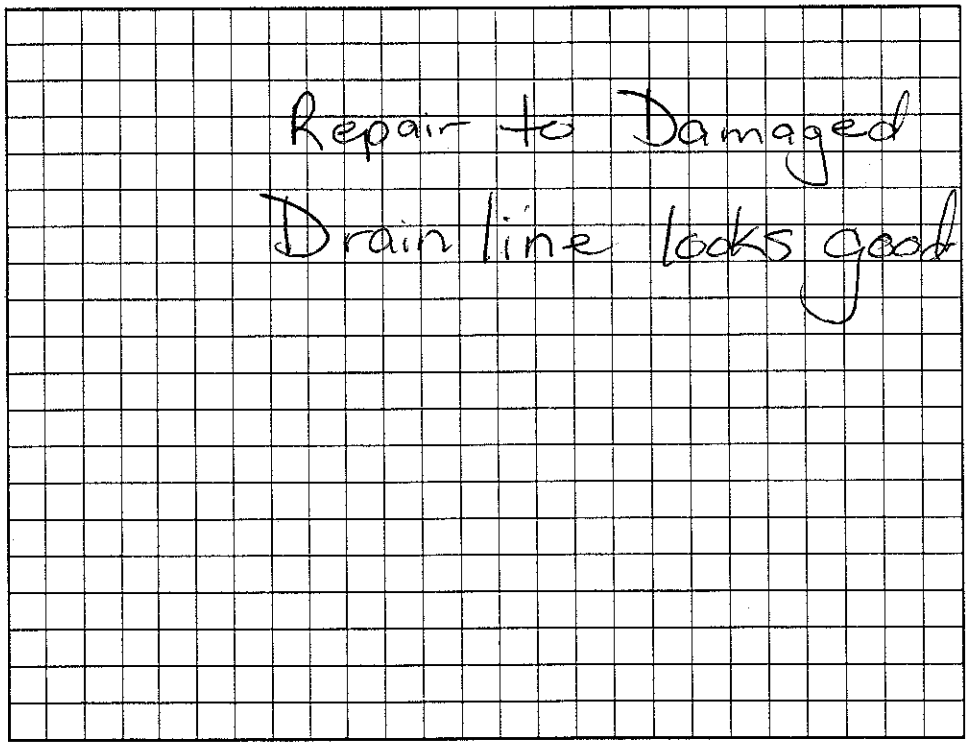

Permit can be suspended or revoked if any false information is supplied toward securing the permit/any unauthorized changes are made to the site/any unauthorized changes are made in the installation of the system. Improvement Permit with plat valid without expiration. Improvement Permit with site plan valid for sixty months. Authorization to Construct is valid for a period equal to that of Improvement Permit – not to exceed sixty months.

Signed: X date 4/24/02 Installed by: R&H Inc

Improvement Permit by: RS date 4/23/02 Operation Permit by: RS date 4/24/2002

Authorization to Construct by: RS date 4/23/02 Existing System Inspection by: date

HEALTH DEPT. COPY: WHITE OWNER COPY (FINAL): YELLOW OWNER COPY (INITIAL): PINK