IREDELL COUNTY HEALTH DEPARTMENT

STATESVILLE 704-878-5305 MOORESVILLE 704-664-5281

IMPROVEMENT PERMIT / CERTIFICATE OF COMPLETION / OPERATION PERMIT / EXISTING SYSTEM INSPECTION

PROPERTY DESCRIPTION NO. 19142 DATE July 8, 194 TAX MAP NO. 2K7F1 4636-89-6064 Watershed: ☑ Yes ☐ No

OWNER OR CONTRACTOR Newman McDade PHONE: Business 892-7991 Home

ADDRESS PO Box 131, Mt Mourne

LOCATION 1100 ft Canvasback on left 1st lot past Regency Blvd.

SUBDIVISION Regency Lake BLOCK / SECTION F LOT 1 LOT AREA 10-15,000 sq ft SITE CLASS. 15 per 18A DESIGN FLOW 360 gpd L.T.A.R. .3

Septic Tank: 1000 Gallons; STB 1012 Tp Date 6-25-94

Pump Tank: Gallons; PT Date

Pump Make: Model Serial No.

Nitrification Field: No Fields 2 Square Feet 1200 Linear Feet 400

No Lines 4+4 Trench Width 36" Max Trench Bottom Depth 36" Gravel Depth 12"

☑ New System ☐ Repair System Type: I, ☑ II, III, IV, V, VI

System Description: gravity conventional

Repair System Description: gravity PPBPS

Maintenance Agreement Required: ☐ Yes ☑ No

☑ House/Mod. Home No. Bedrooms 3

☐ Mobile Home No. Bathrooms 2

☐ Business No. Employees

☐ Other


☐ Slab ☑ Crawl Space ☐ Basement w/plumbing ☐ Basement wo/plumbing

Water Supply: ☐ Individual ☑ Community ☐ Public


Comments:

Comments: Driveway entrance changed to enter off Regency Blvd. Tank set above driveway w/ 3" line under drive to flow divider.

INITIAL SITE SKETCH

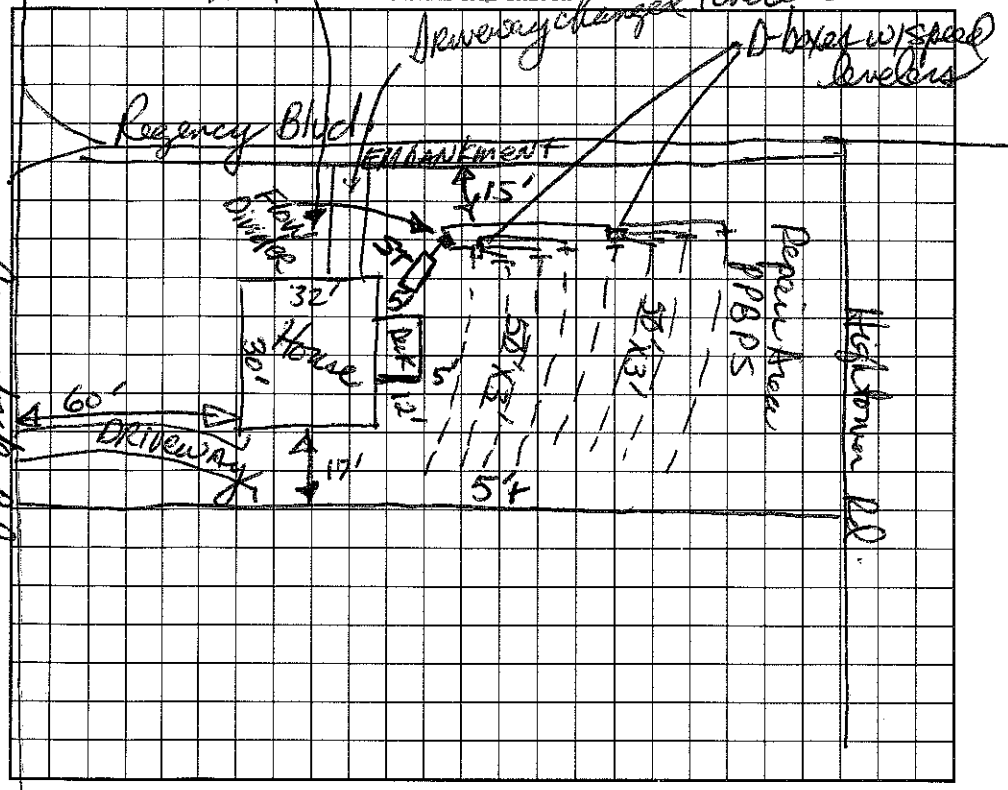

AS BUILT SKETCH

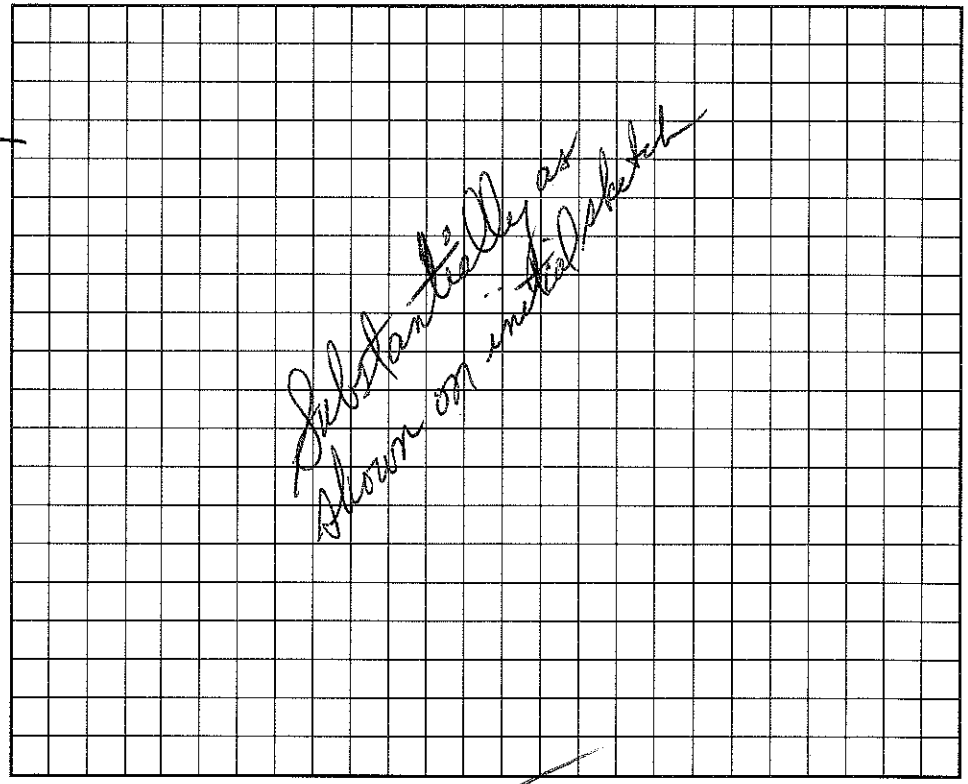

I understand that this permit can be suspended or revoked if any false information is supplied toward securing the permit/any unauthorized changes are made to the site/any unauthorized changes are made in the installation of the system. Improvement Permit is valid for 60 months from date of issuance.

Signed: X Newman McDade

Improvement Permit by: David R. Hinson, RS date 7/8/94

Existing System Inspection by: date

Installed by: Richard Abernathy

Certificate of Completion by: David R. Hinson, RS date 9-16-94

Operation Permit by: date

HEALTH DEPT. COPY: WHITE INSPECTION COPY (FINAL): GREEN OWNER COPY (FINAL): YELLOW INSPECTION COPY (INITIAL): PINK OWNER COPY (INITIAL): GOLD