IREDELL COUNTY HEALTH DEPARTMENT

Statesville Office (704) 878-5305 Mooresville Office (704) 660-3625 PERMIT # 213807

IMPROVEMENT PERMIT / AUTHORIZATION TO CONSTRUCT / OPERATION PERMIT / EXISTING SYSTEM

PIN # 4636921031

APPLICANT: Wieslaw Wroblewski APPLICANT ADDRESS: 515 Canvasback Rd Mooresville, NC 28117

SITE ADDRESS: 515 Canvasback Rd Mooresville, NC PHONE: ALT. PHONE:

SITE DIRECTIONS: Brawley School Rd TL Canvasback on left past Donaldson Landing

SUBDIVISION: Woodland Hills SECTION: 3 LOT # 33 LOT AREA: .494c DESIGN FLOW: 360gpd L.T.A.R.: .5

Exist

Septic Tank 1000 (gal) STB Date
Pump Tank (gal) PT Date
Pump Make Model Serial #
Nitrification Fields 1 # Lines 4 Linear Ft: 300'
Trench Width 36" Max. Trench Bottom Depth 32" Gravel Depth N/A

☐ New System ☑ Repair ☐ Expansion System Type: I II III IV V VI
System Description: Exist. Gravity - 25% Reduction
Repair System Description: LP PBBPS
Maintenance Agreement Required: ☐ YES ☒ NO
☒ GRAVITY ☐ PRESSURE


☒ Residence No. Bedrooms 3
☐ Business No. Persons 6
☐ Other No. Employees
☐ Slab ☒ Crawl Space
☐ Basement w/plumbing ☐ Basement w/o plumbing

Water Supply: ☐ Private ☐ Public ☒ Community

Comments / Conditions:

The proposed deck & gazebo does not appear to impact the existing Septic System.

INITIAL SITE SKETCH

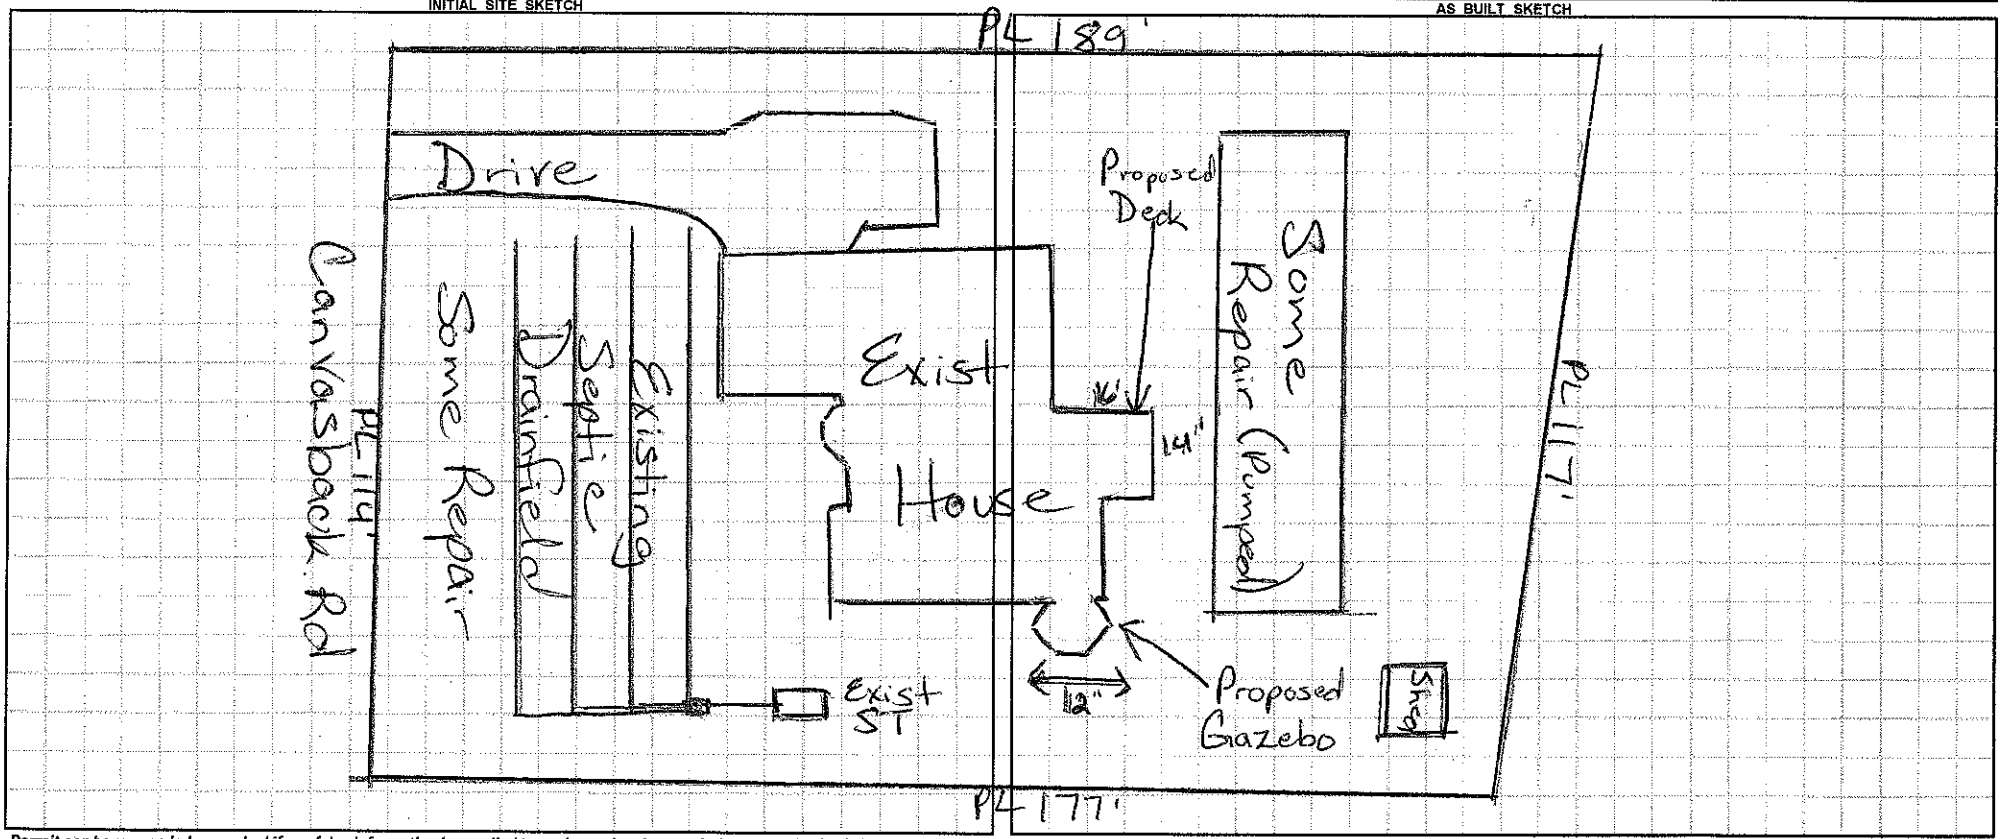

AS BUILT SKETCH

Permit can be suspended or revoked if any false information is supplied toward securing the permit / any unauthorized changes are made to the site / any unauthorized changes are made in the installation of the system. **CONTACT A LOCATOR SERVICE PRIOR TO ANY EXCAVATION**

☐ **IMPROVEMENT PERMIT** *with plat valid without expiration.* ☐ **IMPROVEMENT PERMIT** *with site plan valid for 60 mos.* ☐ **AUTHORIZATION TO CONSTRUCT** *valid for period equal to IMPROVEMENT PERMIT--not to exceed 60 mo.*

Owner / Applicant Signature: W. Wroblewski Date: 11-4-2015 Installed by:

IMPROVEMENT PERMIT by: Date: OPERATION PERMIT by: Date:

AUTHORIZATION TO CONSTRUCT by: Date: Existing System Inspected by: Maria Dotson Date: 10/30/15

Health Dept. Copy - WHITE Applicant (Final Approval) - YELLOW Applicant (Conditional Approval) - PINK

IREDELL COUNTY HEALTH DEPARTMENT

STATESVILLE 704-878-5305 MOORESVILLE 704-664-5281

IMPROVEMENT PERMIT / CERTIFICATE OF COMPLETION / OPERATION PERMIT / EXISTING SYSTEM INSPECTION

PROPERTY DESCRIPTION NO. 21643 DATE 7/19/95 TAX MAP NO. 2G 19 A 33 Watershed: ☒ Yes ☐ No

OWNER OR CONTRACTOR John & Maryanne McCann PHONE: Business ______ Home 892-7373

ADDRESS 933 Olde St Mooresville, NC. 28115 4636921031

LOCATION Conwyback past Donaldson Ldg. to lot on (L) at water

SUBDIVISION Woodland Hills BLOCK / SECTION 3 LOT 33 LOT AREA .49 SITE CLASS. PS DESIGN FLOW 360 L.T.A.R. .3

Septic Tank: 1000 Gallons; STB 794 Date 12/19/95

Pump Tank: ______ Gallons; PT ______ Date ______

Pump Make: ______ Model ______ Serial No. ______

Nitrification Field; No Fields 1 Square Feet ~~1200~~ 900 Linear Feet ~~X~~ 300 Ans

No Lines ~~X~~ 4 Ans Trench Width 36" Max Trench Bottom Depth 32" Gravel Depth N/A

☒ New System ☐ Repair System Type: I, II, (III), IV, V, VI

System Description: GRAVITY INFILTRATOR

Repair System Description: Pressure Panel

Maintenance Agreement Required: ☐ Yes ☐ No

☐ Slab ☒ Crawl Space ☐ Basement w/plumbing ☐ Basement wo/plumbing

☒ House/Mod. Home ☐ Mobile Home ☐ Business ☐ Other ______


No. Bedrooms 3 No. Bathrooms 2 No. Employees ______

Water Supply: ☒ Individual ☒ Community ☐ Public


Comments:

Comments:

INITIAL SITE SKETCH

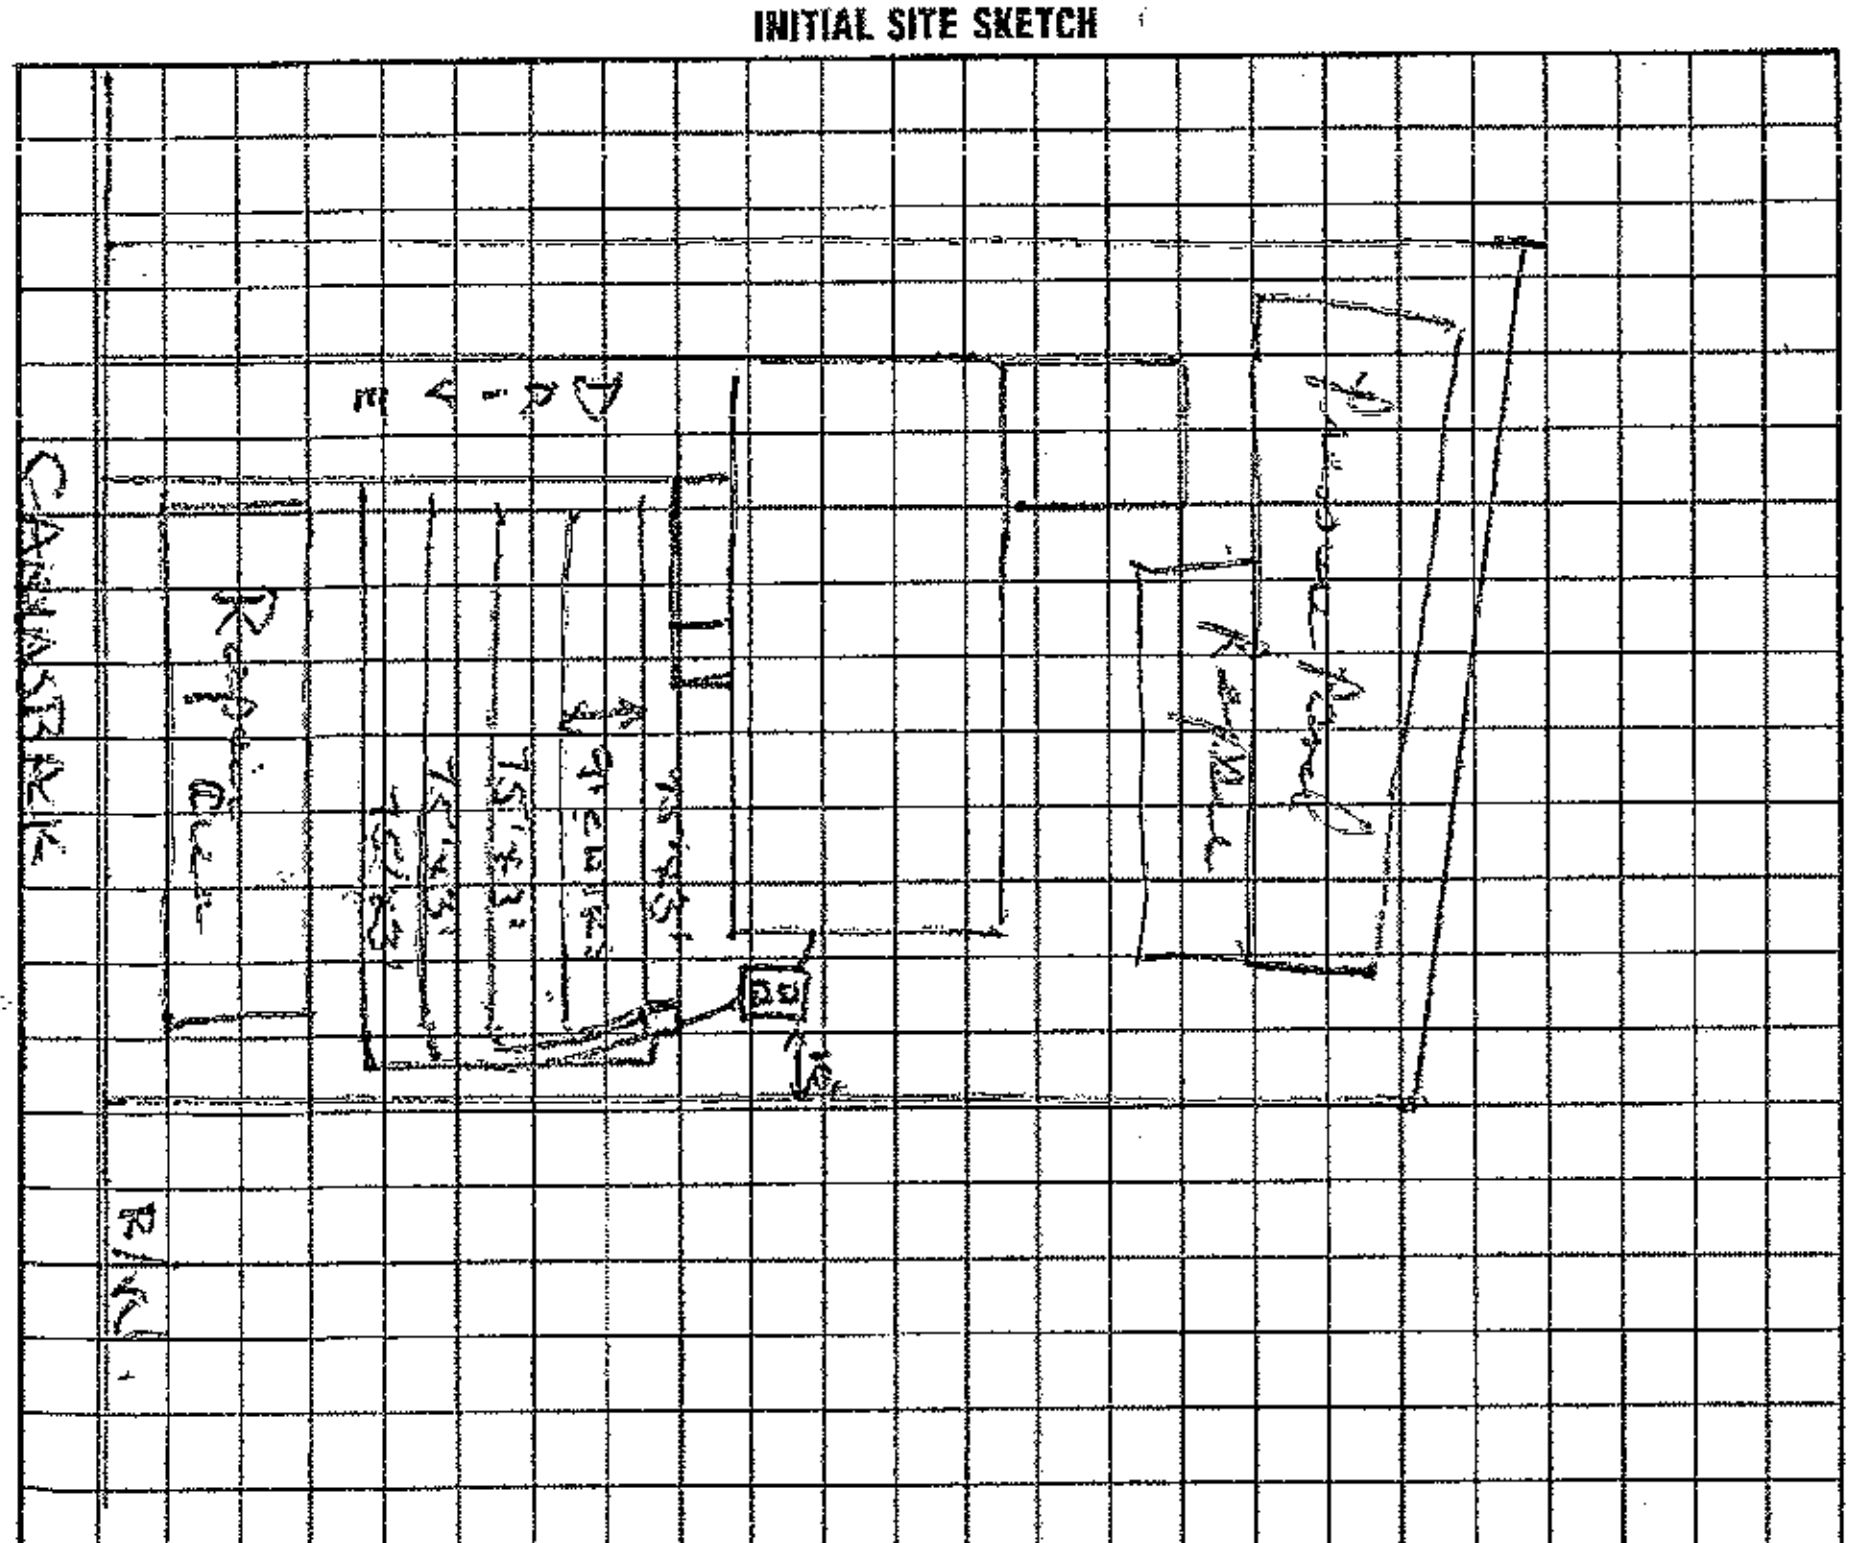

AS BUILT SKETCH

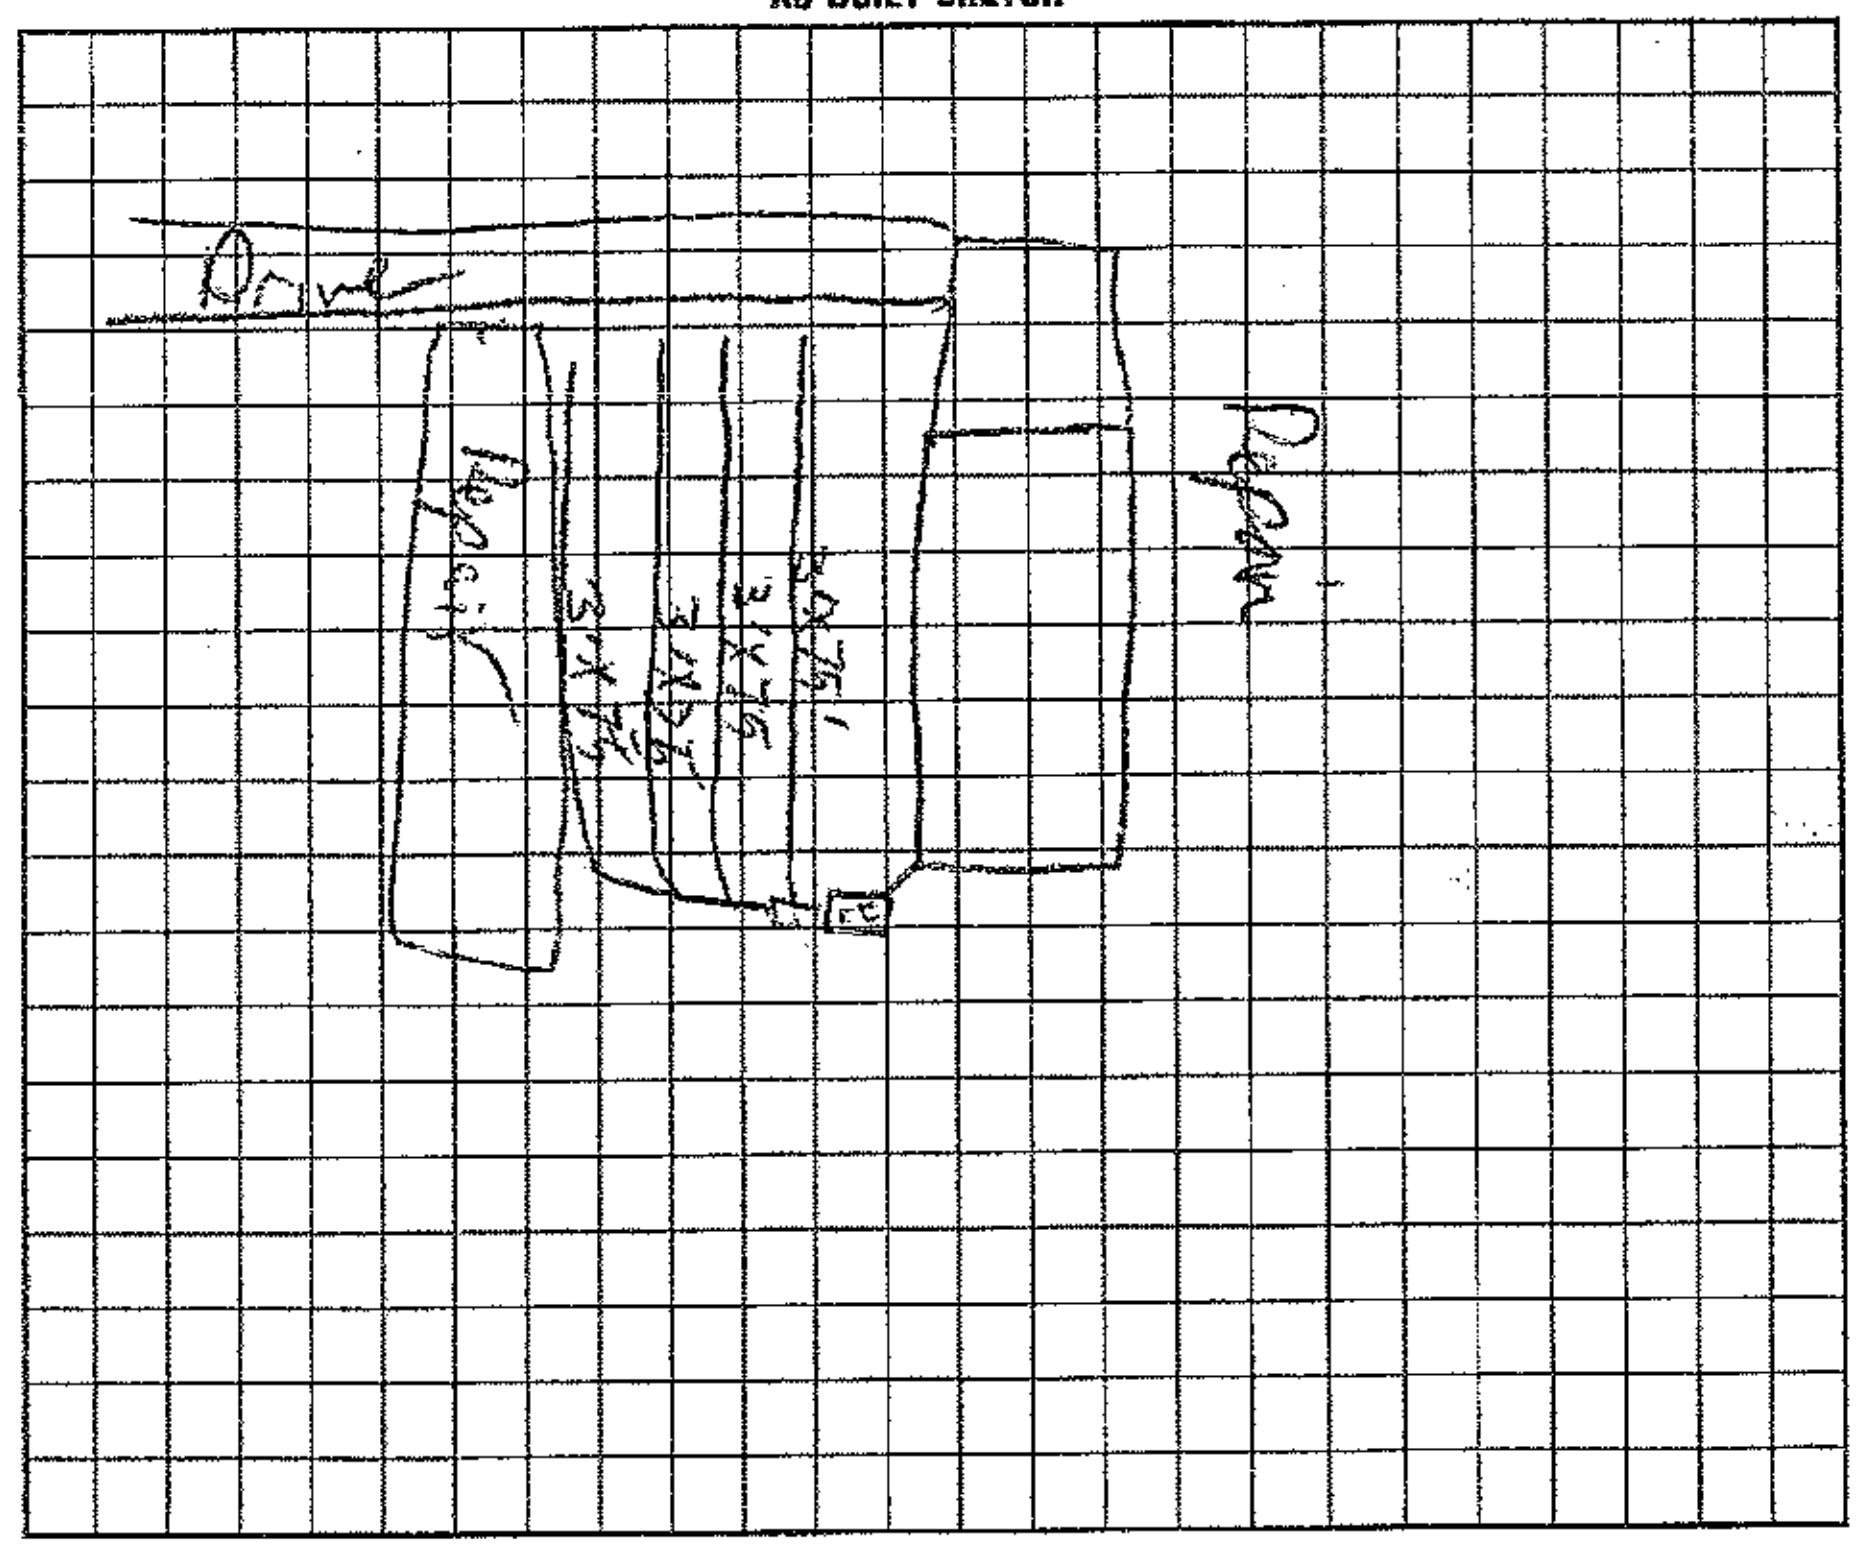

I understand that this permit can be suspended or revoked if any false information is supplied toward securing the permit/any unauthorized changes are made to the site/any unauthorized changes are made in the installation of the system. Improvement Permit is valid for 60 months from date of issuance.

Signed: X John V. McCann

Improvement Permit by: Wesley Sparks RS date 7/19/95

Existing System Inspection by: ______ date ______

Installed by: Larry Bean

Certificate of Completion by: C. Brady Freeman date 3/21/96

Operation Permit by: ______ date ______

HEALTH DEPT. COPY: WHITE INSPECTION COPY (FINAL): GREEN OWNER COPY (FINAL): YELLOW INSPECTION COPY (INITIAL): PINK OWNER COPY (INITIAL): GOLD