IREDELL COUNTY HEALTH DEPARTMENT

STATESVILLE 704-878-5305 MOORESVILLE 704-664-5281

IMPROVEMENT PERMIT / CERTIFICATE OF COMPLETION / OPERATION PERMIT / EXISTING SYSTEM INSPECTION

PROPERTY DESCRIPTION NO. 21643 DATE 7/19/95 TAX MAP NO. 2G 19A 33 Watershed: ☒ Yes ☐ No

OWNER OR CONTRACTOR John + Maryanne McCann PHONE: Business Home 892-7373

ADDRESS 933 Oak St Mooresville, NC. 28115 4636921031

LOCATION Conover, back past Donaldson Lodge to lot on L at curve

SUBDIVISION Woodland Hills BLOCK / SECTION 3 LOT 33 LOT AREA .49 SITE CLASS. PS DESIGN FLOW 360 L.T.A.R. .3

Septic Tank: 1000 Gallons; STB 794 Date 12/19/95

Pump Tank: ____ Gallons; PT ____ Date ____

Pump Make: ____ Model ____ Serial No. ____

Nitrification Field: No Fields 1 Square Feet ~~1200~~ 900 Linear Feet ~~x~~ 300 Rock

No Lines ~~4~~ Rock Trench Width 36" Max Trench Bottom Depth 32" Gravel Depth N/A

☒ New System ☐ Repair System Type: I, II, ☒ III, IV, V, VI

System Description: GRAVITY INFILTRATOR

Repair System Description: Pressure Panel

Maintenance Agreement Required: ☐ Yes ☐ No

☒ House/Mod. Home No. Bedrooms 3

☐ Mobile Home No. Bathrooms 2

☐ Business No. Employees ____

☐ Other ____


☐ Slab ☒ Crawl Space ☐ Basement w/plumbing ☐ Basement wo/plumbing

Water Supply: ☐ Individual ☒ Community ☐ Public


Comments:

Comments:

INITIAL SITE SKETCH

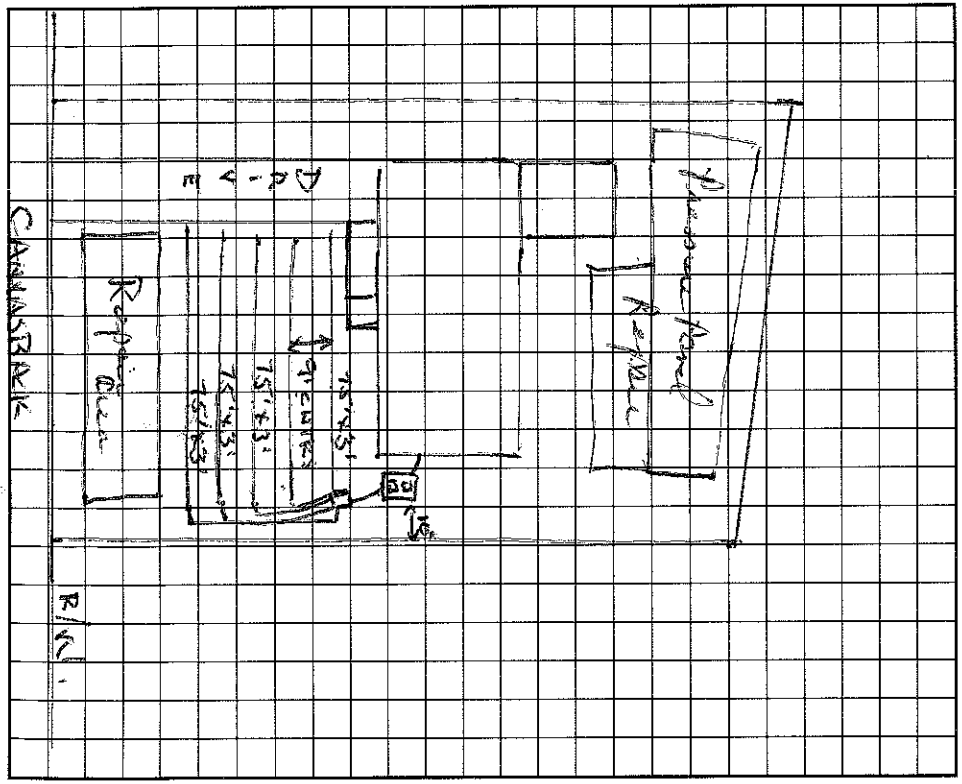

AS BUILT SKETCH

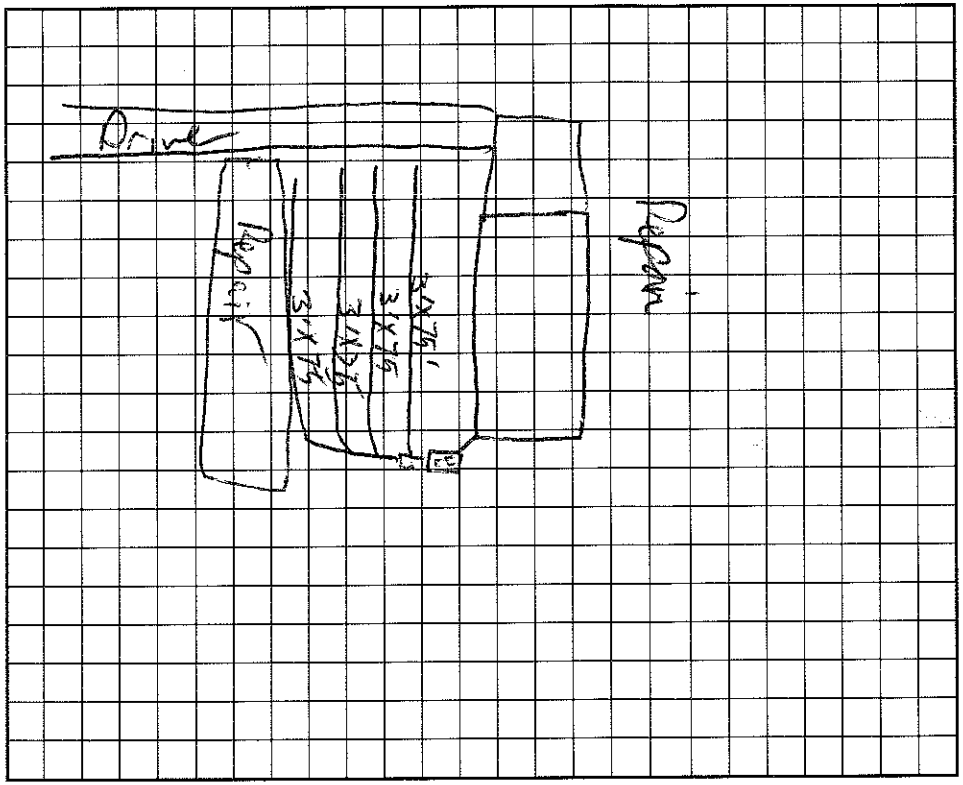

I understand that this permit can be suspended or revoked if any false information is supplied toward securing the permit/any unauthorized changes are made to the site/any unauthorized changes are made in the installation of the system. Improvement Permit is valid for 60 months from date of issuance.

Signed: X [signature]

Improvement Permit by: Wesley Sparks RS date 7/19/95

Existing System Inspection by: ____ date ____

Installed by: Larry Beam

Certificate of Completion by: C. Brady Trexler date 3/21/96

Operation Permit by: ____ date ____

HEALTH DEPT. COPY: WHITE INSPECTION COPY (FINAL): GREEN OWNER COPY (FINAL): YELLOW INSPECTION COPY (INITIAL): PINK OWNER COPY (INITIAL): GOLD