IREDELL COUNTY HEALTH DEPARTMENT

STATESVILLE 704-878-5305 MOORESVILLE 704-664-5281

IMPROVEMENT PERMIT / CERTIFICATE OF COMPLETION / OPERATION PERMIT / EXISTING SYSTEM INSPECTION

PROPERTY DESCRIPTION NO. _____ DATE May 23, 96 TAX MAP NO. 2GTYA98 4636-93-1615 Watershed: ☑ Yes ☐ No

OWNER OR CONTRACTOR Donna & John Moffett PHONE: Business _____ Home _____

ADDRESS Ring Neck Trail Mooresville

LOCATION Canvasback TL Broadbill TR Ring Neck Trail ~ 3rd on Right (repair)

SUBDIVISION Woodland Hills BLOCK / SECTION A LOT 98 LOT AREA part of Lot 117 SITE CLASS. _____ DESIGN FLOW 600gpd L.T.A.R. .3

Septic Tank: Existing Gallons; STB _____ Date _____

Pump Tank: Existing Gallons; PT _____ Date _____

Pump Make: _____ Model _____ Serial No. _____

Nitrification Field: No. Fields 2 Square Feet 680 Linear Feet 340

No. Lines 8 3 Trench Width 24" Max Trench Bottom Depth ~30" Gravel Depth NA

☐ New System ☑ Repair System Type: I, II, III, IV, V, VI

System Description: LPPPBS

Repair System Description: LPPPBPS

Maintenance Agreement Required: ☑ Yes ☐ No

☑ House/Mod. Home No. Bedrooms 5

☐ Mobile Home No. Bathrooms 3

☐ Business No. Employees _____

☐ Other _____

☐ Slab ☐ Crawl Space ☑ Basement w/plumbing ☐ Basement wo/plumbing

Water Supply: ☐ Individual ☑ Community ☐ Public


Comments: X ONSITE PRE CONSTRUCTION CONFERENCE REQUIRED W/ INSTALLER X

Comments: IF WATER LINE IS ENCOUNTERED - MUST GO BELOW IT W/ SUPPLY LINE (18" MIN SEPARATION)


DOT MUST BE CONTACTED RE: CROSSING RING NECK TR.

NOT TO SCALE

INITIAL SITE SKETCH

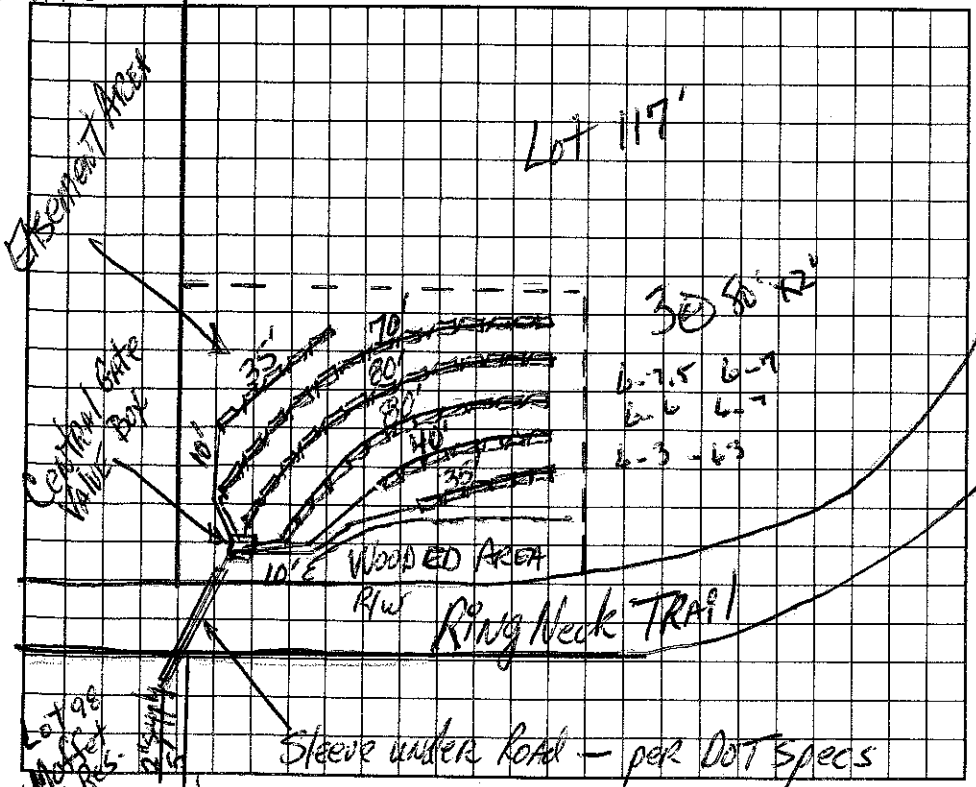

AS BUILT SKETCH

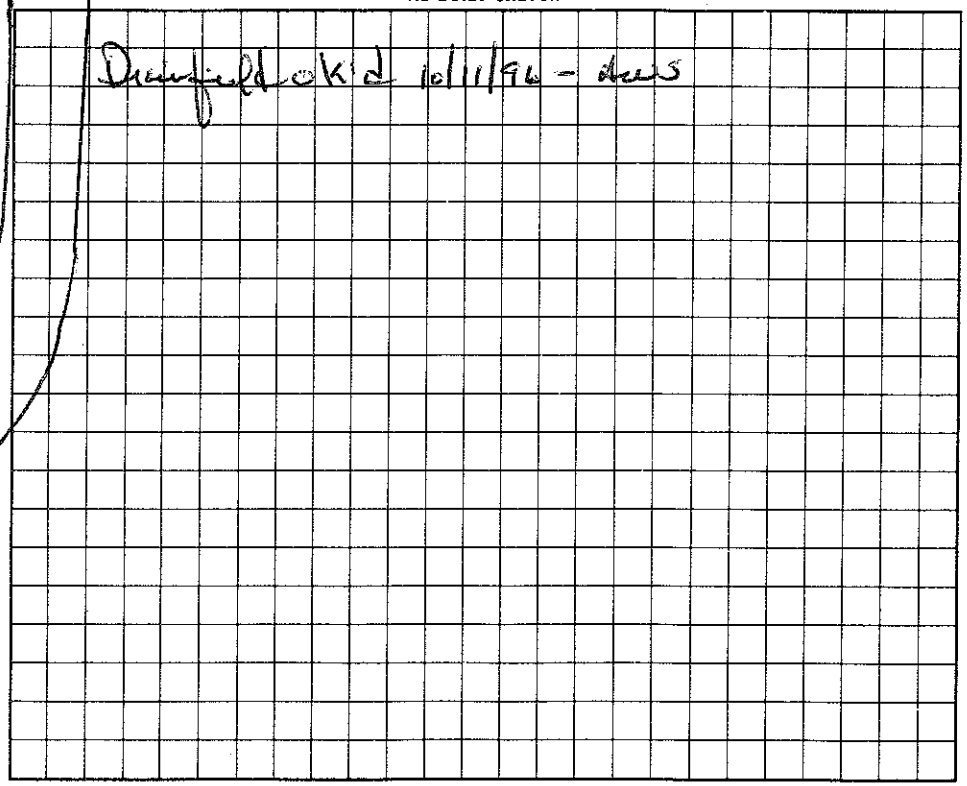

I understand that this permit can be suspended or revoked if any false information is supplied toward securing the permit/any unauthorized changes are made to the site/any unauthorized changes are made in the installation of the system.

Signed: _____

Improvement Permit by: _____ date 5-23-96

Existing System Inspection by: _____ date _____

Installed by: Tim Simmons

Certificate of Completion by: _____ date 2/17/97

Operation Permit by: _____ date 2/17/97

HEALTH DEPT. COPY: WHITE INSPECTION COPY (FINAL): GREEN OWNER COPY (FINAL): YELLOW INSPECTION COPY (INITIAL): PINK OWNER COPY (INITIAL): GOLD