IREDELL COUNTY HEALTH DEPARTMENT

STATESVILLE 704-878-5305 MOORESVILLE 704-664-5281

IMPROVEMENT PERMIT / CERTIFICATE OF COMPLETION / OPERATION PERMIT / EXISTING SYSTEM INSPECTION

PROPERTY DESCRIPTION NO. 12380 DATE March 3, 195 TAX MAP NO. 26 194 A 116

OWNER OR CONTRACTOR Kelly Custom Homes PHONE: Business Home

ADDRESS PO Box 117 Mt Mourne Watershed: ☒ Yes ☐ No WS IV

LOCATION Brawley School Road TL Canvasback TL Bradstell TR Ring Neck TR on left in curve

SUBDIVISION Woodland Hills BLOCK / SECTION LOT 116 LOT AREA .53 Ac SITE CLASS RS DESIGN FLOW 360 gpd L.T.A.R. .3

Septic Tank: 1000 Gallons; STB 794 Date 5-11-95

Pump Tank: Gallons; PT Date

Pump Make: Model Serial No.

Nitrification Field: No Fields 1 Square Feet 1200 Linear Feet 400

No Lines 3 Trench Width 36" Max Trench Bottom Depth 30" Gravel Depth 12"

☒ New System ☐ Repair System Type: I, II, III, IV, V, VI

System Description: gravity conventional

Repair System Description: gravel pumped conv.

Maintenance Agreement Required: ☐ Yes ☒ No

☒ House/Mod. Home No. Bedrooms 3

☐ Mobile Home No. Bathrooms 2½

☐ Business No. Employees

☐ Other


☐ Slab ☒ Crawl Space ☐ Basement w/plumbing ☐ Basement wo/plumbing

Water Supply: ☐ Individual ☒ Community ☐ Public

Comments: Laterals to follow contour

Comments: Installed as drawn on App. Permit

INITIAL SITE SKETCH

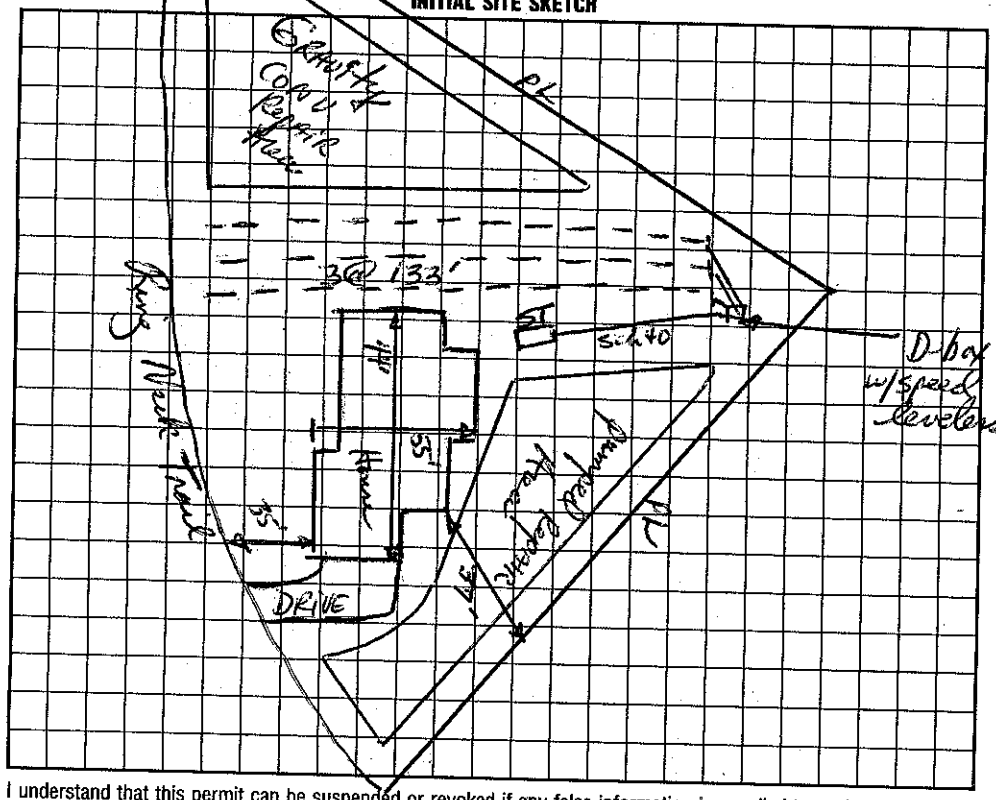

AS BUILT SKETCH

I understand that this permit can be suspended or revoked if any false information is supplied toward securing the permit/any unauthorized changes are made to the site/any unauthorized changes are made in the installation of the system. Improvement Permit is valid for 60 months from date of issuance.

Signed: X Karen Kelly

Improvement Permit by: Jack Heffner RS date 3/3/95

System Inspection by: date

Installed by: A Cornelius Grading

Certificate of Completion by: Wesley Sparks RS date 7/28/95

Operation Permit by: date

HEALTH DEPT. COPY: WHITE INSPECTION COPY (FINAL): GREEN OWNER COPY (FINAL): YELLOW INSPECTION COPY (INITIAL): PINK OWNER COPY (INITIAL): GOLD