IREDELL COUNTY HEALTH DEPARTMENT

IMPROVEMENT PERMIT / ~~CERTIFICATE OF COMPLETION~~ / OPERATION PERMIT / EXISTING SYSTEM INSPECTION

STATESVILLE 704-878-5305 MOORESVILLE 704-664-5281

Authorized 4636941234

PROPERTY DESCRIPTION NO. 24394 DATE 8/19/96

OWNER OR CONTRACTOR WEB WALKER TAX MAP NO. 26-19-A-103

ADDRESS 1611 MECKLENBURG HWY MOORESVILLE NC 28115 PHONE: Business 522-4507 Home 6

LOCATION BRAWLEY SCHOOL - TL CANVASBACK - TL BROADBILL - TR RINGNECK - LOT ON RT

SUBDIVISION WOODLANDHILLS BLOCK / SECTION 8 LOT 103 LOT AREA — SITE CLASS. P5 DESIGN FLOW ~~360~~ 480 L.T.A.R. .3 gpd/FT

Watershed: ☒ Yes ☐ No

Septic Tank: 1000 Gallons; STB 794 Date 11/6/96

Pump Tank: — Gallons; PT — Date —

Pump Make: — Model — Serial No. —

Nitrification Field: No Fields 1 Square Feet 810 Linear Feet 270

No Lines 9 Trench Width 24" Max Trench Bottom Depth 36" Gravel Depth N/A

☑ New System ☐ Repair System Type: I, II, (III), IV, V, VI

System Description: GRAVITY PANEL

Repair System Description: PUMP CHAMBER

Maintenance Agreement Required: ☐ Yes ☑ No

☑ House/Mod. Home ☐ Mobile Home ☐ Business ☐ Other

No. Bedrooms 4 No. Bathrooms 2.5 No. Employees —

☐ Slab ☑ Crawl Space ☐ Basement w/plumbing ☐ Basement wo/plumbing


Water Supply: ☐ Individual ☐ Community ☑ Public

Comments:


Comments:

1"=30'

INITIAL SITE SKETCH

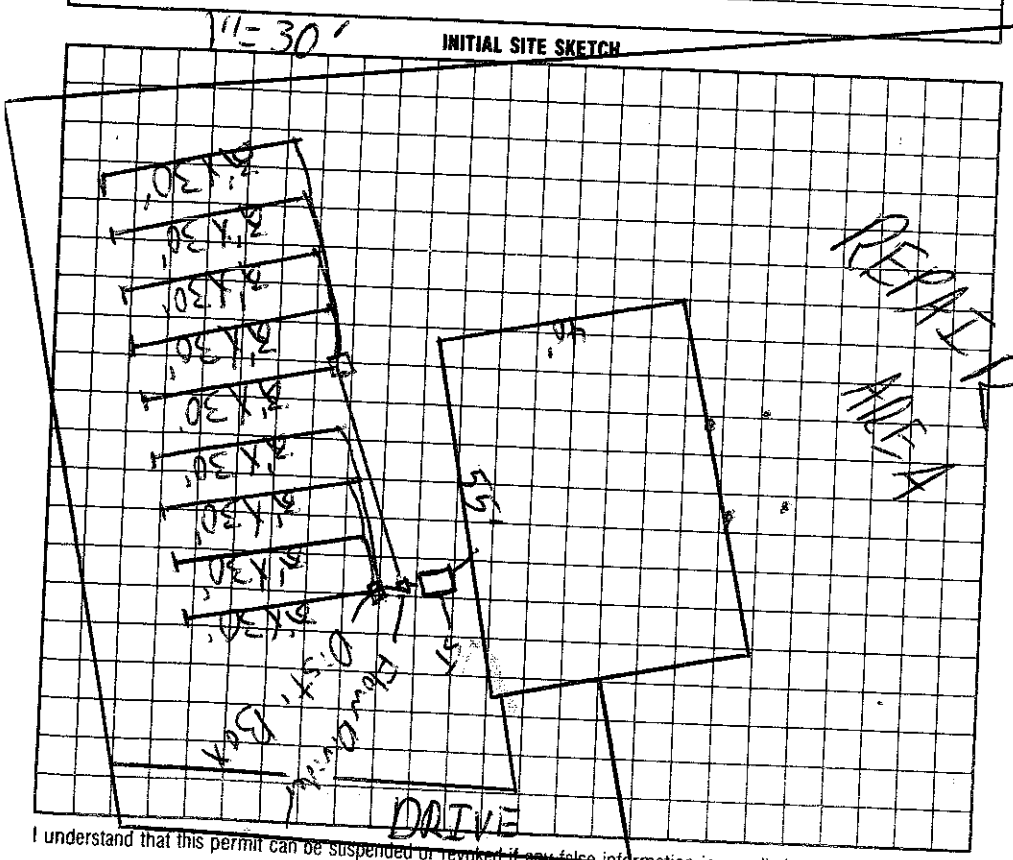

AS BUILT SKETCH

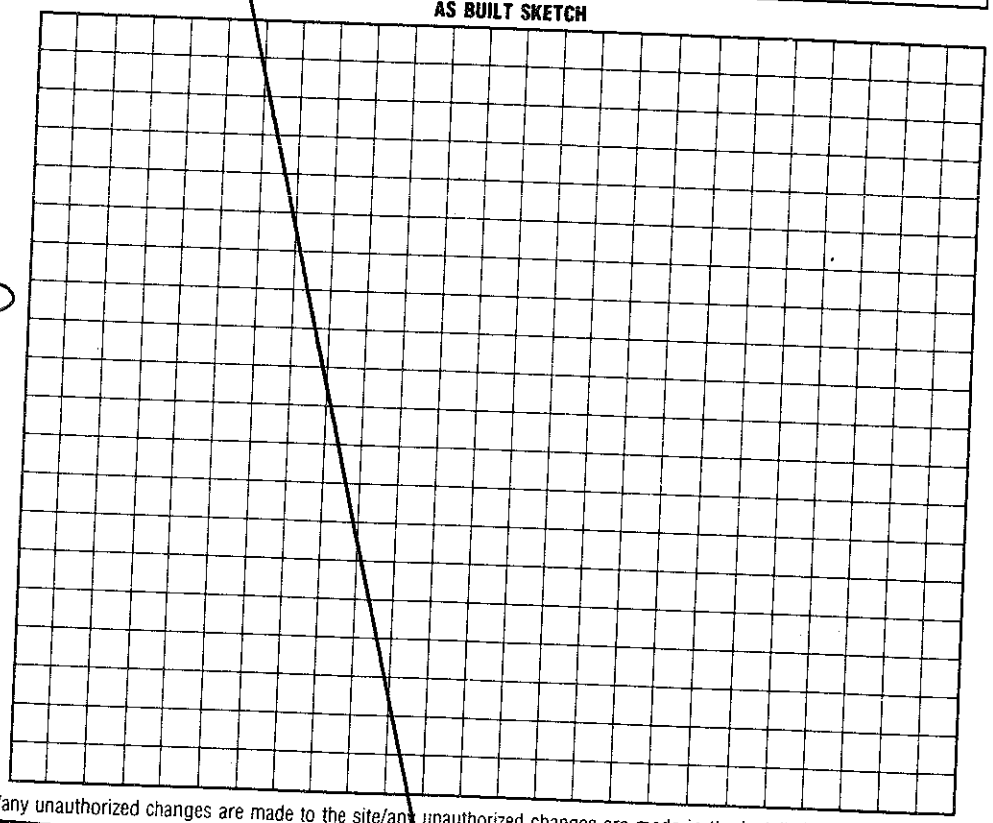

I understand that this permit can be suspended or revoked if any false information is supplied toward securing the permit/any unauthorized changes are made to the site/any unauthorized changes are made in the installation of the system.

Signed: Suzanne B Walker

Improvement Permit by: C Ruby Treem EHST date 8/19/96

AUTHORIZATION TO CONSTRUCT Existing System Inspection by: C Ruby Treem EHST date 8/19/96

Installed by: WT Norwood

Certificate of Completion by: — date —

Operation Permit by: C Ruby Treem date 1-27-97

HEALTH DEPT. COPY: WHITE INSPECTION COPY (FINAL): GREEN OWNER COPY (FINAL): YELLOW INSPECTION COPY (INITIAL): PINK OWNER COPY (INITIAL): GOLD