IREDELL COUNTY HEALTH DEPARTMENT

AUTHORIZATION TO CONSTRUCT

STATESVILLE 704-878-5305 MOORESVILLE 704-664-5281

IMPROVEMENT PERMIT / ~~CERTIFICATE OF COMPLETION~~ / OPERATION PERMIT / EXISTING SYSTEM INSPECTION

PROPERTY DESCRIPTION NO. 2612 DATE 2/27/97 TAX MAP NO. 4636941385 Watershed: ☑ Yes ☐ No

OWNER OR CONTRACTOR KEN KOONTZ PHONE: Business 662-6556 Home

ADDRESS 191 KEATS RD MOORESVILLE NC 28115

LOCATION BRAWLEY SCHOOL RD. - TL CANVASBACK - TL BROADBILL - TR RINGNECK - 3RD LOT ON RT.

SUBDIVISION WOODLAND HILLS BLOCK / SECTION 8 LOT 104 LOT AREA - SITE CLASS. PS DESIGN FLOW 360 GPD L.T.A.R. .3 GPD/FT²

Septic Tank: 1000 Gallons; STB 825 Date 3/22/98

Pump Tank: ____ Gallons; PT ____ Date ____

Pump Make: ____ Model ____ Serial No. ____

Nitrification Field: No Fields 1 Square Feet 1200 Linear Feet 400

No Lines 6 Trench Width 36" Max Trench Bottom Depth 36" Gravel Depth 12"

☑ New System ☐ Repair System Type: I (II) III, IV, V, VI

System Description: GRAVITY CONVENTIONAL

Repair System Description: "/PUMP CHAMBERED OR SIMILAR

Maintenance Agreement Required: ☐ Yes ☑ No

☑ House/Mod. Home No. Bedrooms 3

☐ Mobile Home No. Bathrooms 2½

☐ Business No. Employees ____

☐ Other ____


☐ Slab ☑ Crawl Space ☐ Basement w/plumbing ☐ Basement wo/plumbing

Water Supply: ☐ Individual ☑ Community ☐ Public


Comments:

Comments: 4 @ 100'

INITIAL SITE SKETCH 1"=40'

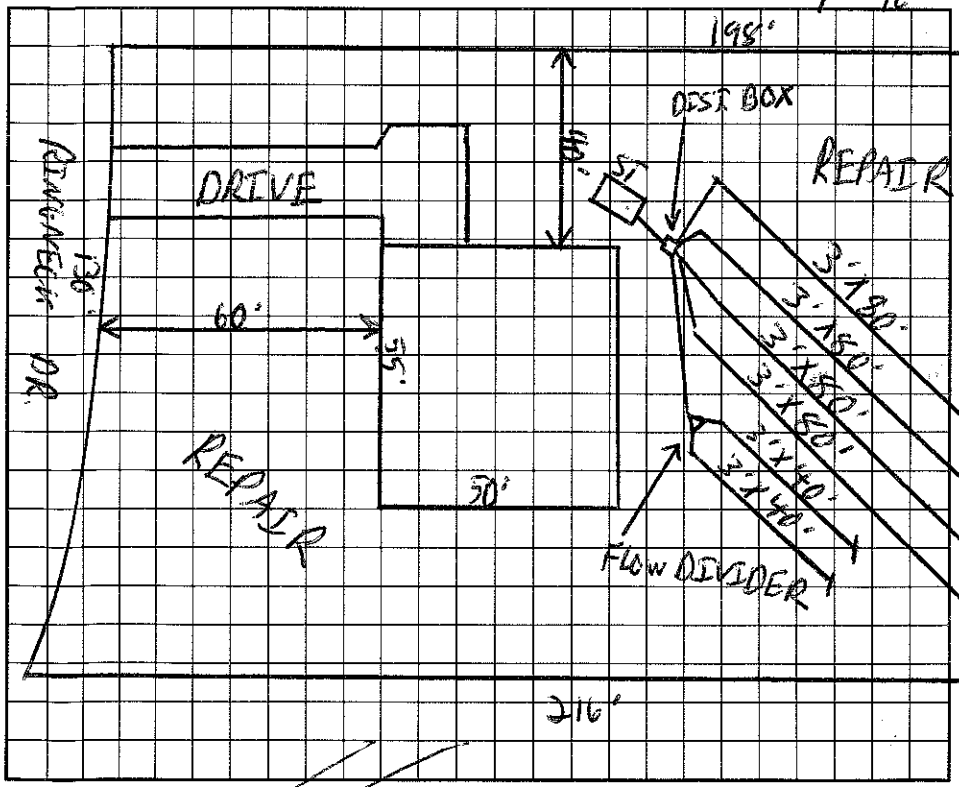

AS BUILT SKETCH

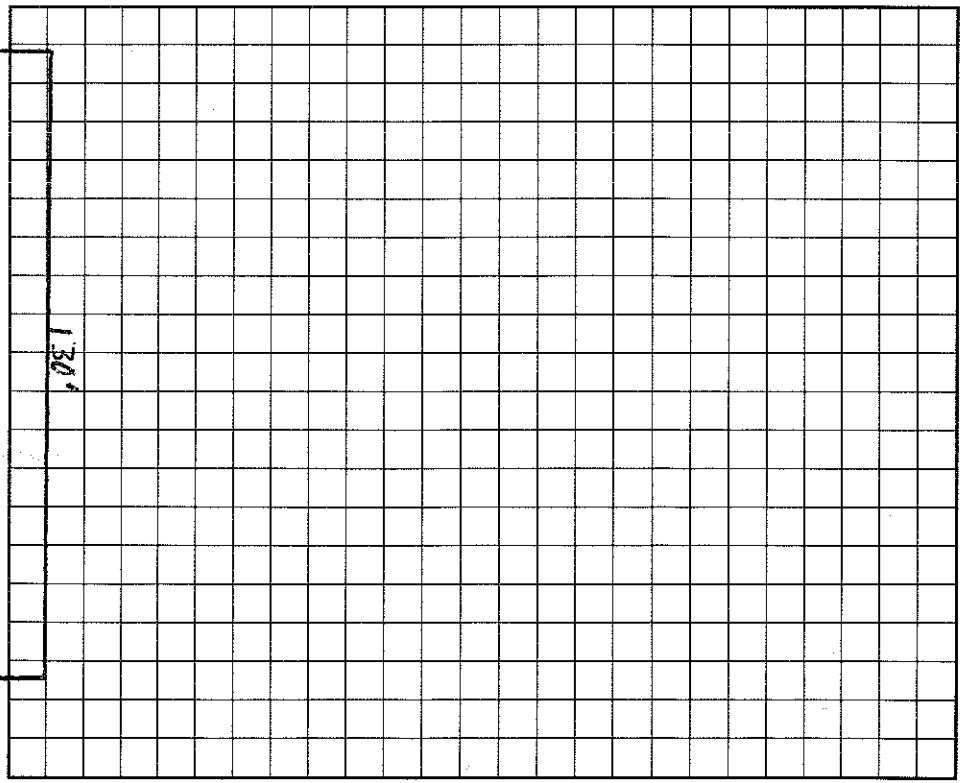

I understand that this permit can be suspended or revoked if any false information is supplied toward securing the permit/any unauthorized changes are made to the site/any unauthorized changes are made in the installation of the system. Improvement Permit is valid for 60 months from date of issuance.

Signed: [signature]

Improvement Permit by: [signature] date 2/27/97

AUTHORIZATION TO CONSTRUCT Existing System Inspection by: [signature] date 2/27/97

Installed by: WAYNE CLONTZ

Certificate of Completion by: ____ date ____

Operation Permit by: [signature] date 5/5/98

HEALTH DEPT. COPY: WHITE INSPECTION COPY (FINAL): GREEN OWNER COPY (FINAL): YELLOW INSPECTION COPY (INITIAL): PINK OWNER COPY (INITIAL): GOLD