IREDELL COUNTY HEALTH DEPARTMENT

AUTHORIZATION TO CONSTRUCT 3.00

STATESVILLE 704-878-5305 MOORESVILLE 704-664-5281

IMPROVEMENT PERMIT / ~~CERTIFICATE OF COMPLETION~~ / OPERATION PERMIT / EXISTING SYSTEM INSPECTION

PROPERTY DESCRIPTION NO. 26169 DATE 5/15/97 TAX MAP NO. 4636941594 Watershed: ☒ ~~Yes~~ ☐ No

OWNER OR CONTRACTOR KEN KOONTZ PHONE: Business Home 662-6556

ADDRESS BRAWLEY SCHOOL RD - TL CANVASBACK - TL BROADBELL - 5TH LOT ON RT

LOCATION

SUBDIVISION WOODLAND HILLS BLOCK / SECTION LOT 108 LOT AREA SITE CLASS. PS DESIGN FLOW 360 GPD L.T.A.R. 360 GPD/FT

Septic Tank: 1000 Gallons; STB 794 Date 11/26/96

Pump Tank: Gallons; PT Date

Pump Make: Model Serial No.

Nitrification Field: No Fields 1 Square Feet 400 Linear Feet 200

No Lines 5 @ 40' Trench Width 24" Max Trench Bottom Depth 36" Gravel Depth N/A

☒ New System ☐ Repair System Type: I, II, (III), IV, V, VI

System Description: GRAVITY PANEL

Repair System Description: GRAVITY/PUMP PANEL

Maintenance Agreement Required: ☐ Yes ☒ No

☒ House/Mod. Home No. Bedrooms 3

☐ Mobile Home No. Bathrooms 2

☐ Business No. Employees

☐ Other


☐ Slab ☒ Crawl Space ☐ Basement w/plumbing ☐ Basement wo/plumbing

Water Supply: ☐ Individual ☒ Community ☐ Public

Comments:

Comments:

INITIAL SITE SKETCH

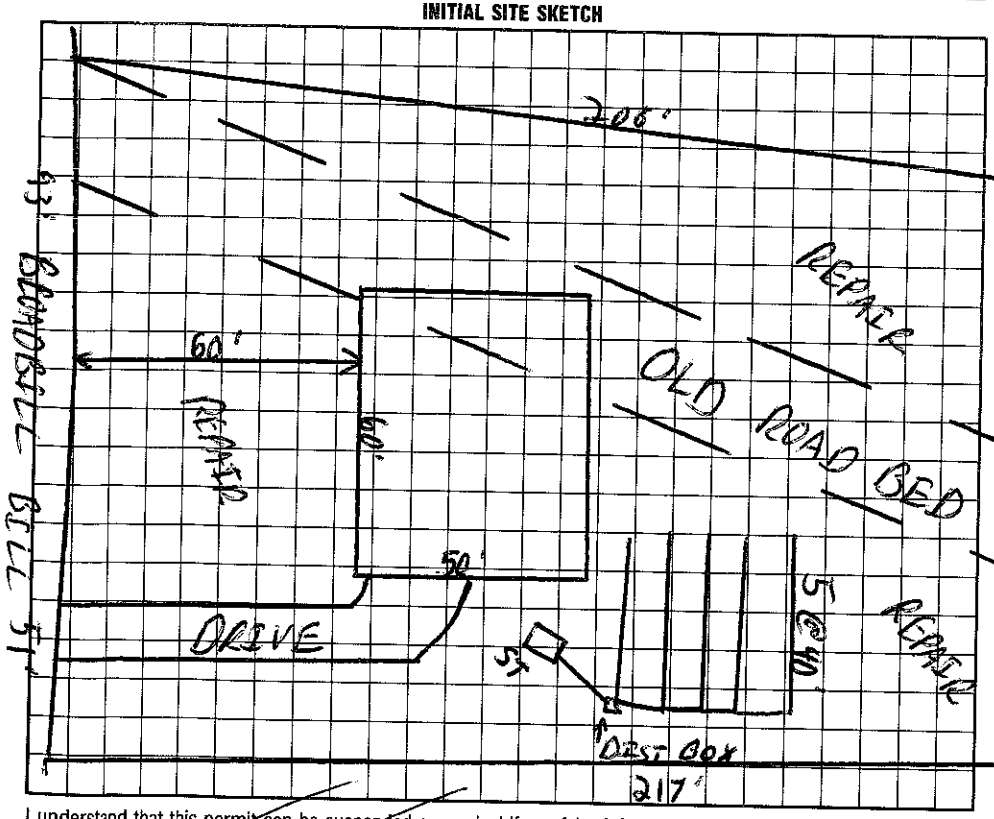

AS BUILT SKETCH

I understand that this permit can be suspended or revoked if any false information is supplied toward securing the permit/any unauthorized changes are made to the site/any unauthorized changes are made in the installation of the system. Improvement Permit is valid for 60 months from date of issuance.

Signed:

Improvement Permit by: date 5/15/97

Existing System Inspection by: date 5/15/97

(CONSTRUCT AUTHORIZATION TO)

Installed by: FJ ERVIN

Certificate of Completion by: date

Operation Permit by: date 3/3/98

HEALTH DEPT. COPY: WHITE INSPECTION COPY (FINAL): GREEN OWNER COPY (FINAL): YELLOW INSPECTION COPY (INITIAL): PINK OWNER COPY (INITIAL): GOLD