IREDELL COUNTY HEALTH DEPARTMENT

STATESVILLE 704-878-5305 MOORESVILLE 704-664-5281

IMPROVEMENT PERMIT / AUTHORIZATION TO CONSTRUCT / OPERATION PERMIT / EXISTING SYSTEM INSPECTION

PERMIT # 129240 PIN # 4636 94 1894 DATE 5/8/09

OWNER or APPLICANT SUSAN JOOSTEN PHONE: Business Home: 704 660 6595

OWNER or APPLICANT ADDRESS 140 BROADBILL DR. MOORESVILLE, NC. 28117

LOCATION / DIRECTIONS 1100 TL CANVASBACK TL BROADBILL DR. TO 5TH HOUSE ON (R) #140

SUBDIVISION WOODLAND HILLS BLOCK / SECTION 8 LOT # 108 LOT AREA .64 DESIGN FLOW 360 L.T.A.R.

Septic Tank 1000 EXISTING Gallons Date

Pump Tank Gallons: PT Date

Pump Make Model Serial #

Nitrification Field No Fields EXISTING No Lines Linear Feet 200

Trench Width 2' Max. Trench Bottom Depth 3' Gravel Depth

☐ New System ☐ Repair ☐ Expansion System Type I II (III) IV V VI

System Description: GRAVITY - 16" PPBPS

Repair System Description:

Maintenance Agreement Required ☐ YES ☒ NO

☒ GRAVITY ☐ PRESSURE

☒ Residence No. Bedrooms 3

☐ Business No. Persons

☐ Other No. Employees

☐ Slab ☒ Crawl Space

☐ Basement w/plumbing ☐ Basement w/o plumbing

Water Supply: ☐ Private ☐ Public ☒ Community


Comments / Conditions

Comments / Conditions

REPAIR

INITIAL SITE SKETCH

AS BUILT SKETCH

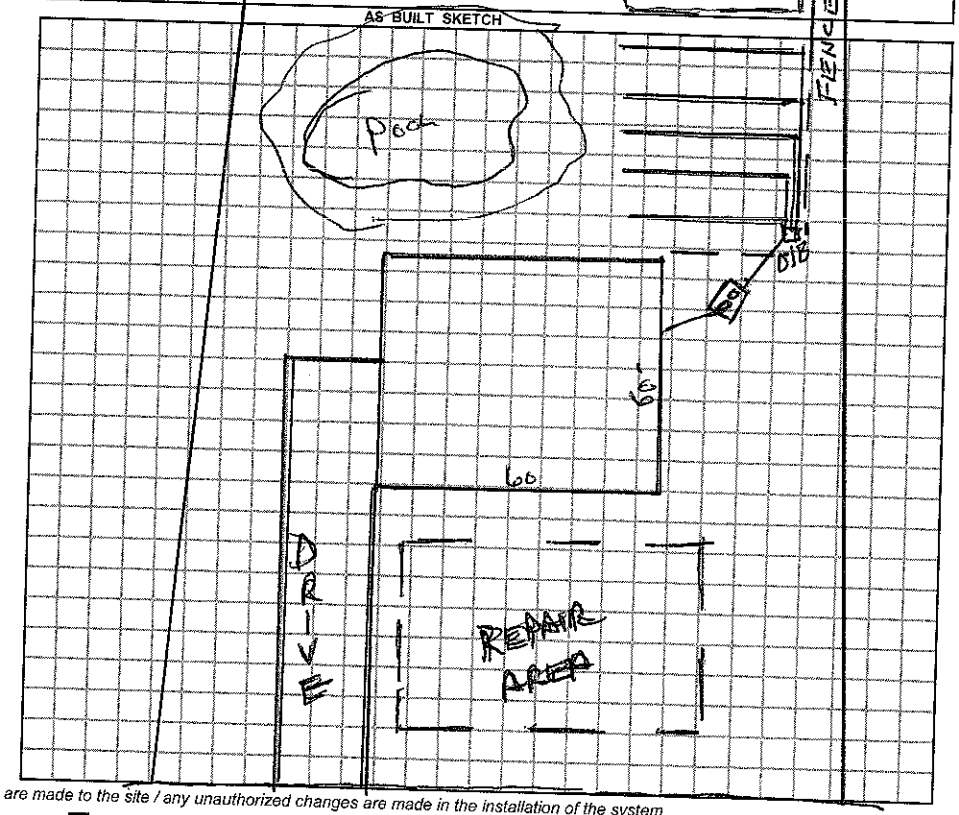

Permit can be suspended or revoked if any false information is supplied toward securing the permit / any unauthorized changes are made to the site / any unauthorized changes are made in the installation of the system.

☐ *IMPROVEMENT PERMIT w / plat valid without expiration.* ☐ *IMPROVEMENT PERMIT w / site plan valid for 60 mos.* ☐ *AUTHORIZATION TO CONSTRUCT valid for period equal to IMPROVEMENT PERMIT-not to exceed 60 mo.*

Owner / Applicant Signature: S Joosten Date 5-13-09 Installed by:

Improvement Permit by: Date

Authorization to Construct by: Date

Operation Permit by: Date:

Existing System Inspected by: Wesley Sparks RS. Date: 5/8/09

YOU SHOULD CONTACT A LOCATOR SERVICE PRIOR TO ANY EXCAVATION.

WHITE COPY Environmental Health YELLOW COPY (Final) Owner / Applicant PINK COPY (Initial) Owner / Applicant