IREDELL COUNTY HEALTH DEPARTMENT

AUTHORIZATION TO CONSTRUCT (11:30) –

STATESVILLE 704-878-5305 MOORESVILLE 704-664-5281

IMPROVEMENT PERMIT / ~~CERTIFICATE OF COMPLETION~~ / OPERATION PERMIT / EXISTING SYSTEM INSPECTION

PROPERTY DESCRIPTION NO. 065686 DATE 4/11/97

OWNER OR CONTRACTOR MILESTONE BUILDERS TAX MAP NO. 4636 94 1946

ADDRESS 522 RIVER HWY. MOORESVILLE NC 28115 PHONE: Business _____ Home _____ Watershed: ☑ Yes ☐ No

LOCATION BRAWLEY SCHOOL RD - TL CANVASBACK - TL BROADBILL - ON RT

SUBDIVISION WOODLAND HILLS BLOCK / SECTION 8 LOT 109 LOT AREA – SITE CLASS. RS DESIGN FLOW 360GPD L.T.A.R. .3 GPD/FT²

Septic Tank: 1000 Gallons; STB 825 Date 9/1/97

Pump Tank: _____ Gallons; PT _____ Date _____

Pump Make: _____ Model _____ Serial No. _____

Nitrification Field: No Fields 1 Square Feet 1200 Linear Feet 400

No Lines 5 @ 80' Trench Width 36" Max Trench Bottom Depth 36" Gravel Depth 12"

☑ New System ☐ Repair System Type: I, (II), III, IV, V, VI

System Description: GRAVITY CONVENTIONAL

Repair System Description: CHAMBERED

Maintenance Agreement Required: ☐ Yes ☑ No

☑ House/Mod. Home ☐ Mobile Home ☐ Business ☐ Other

No. Bedrooms 3 No. Bathrooms 2 No. Employees _____


☐ Slab ☑ Crawl Space ☐ Basement w/plumbing ☐ Basement wo/plumbing

Water Supply: ☑ Individual ☑ Community ☐ Public


Comments:

Comments: 4 @ 100' INSTALLED

INITIAL SITE SKETCH 1" = 40'

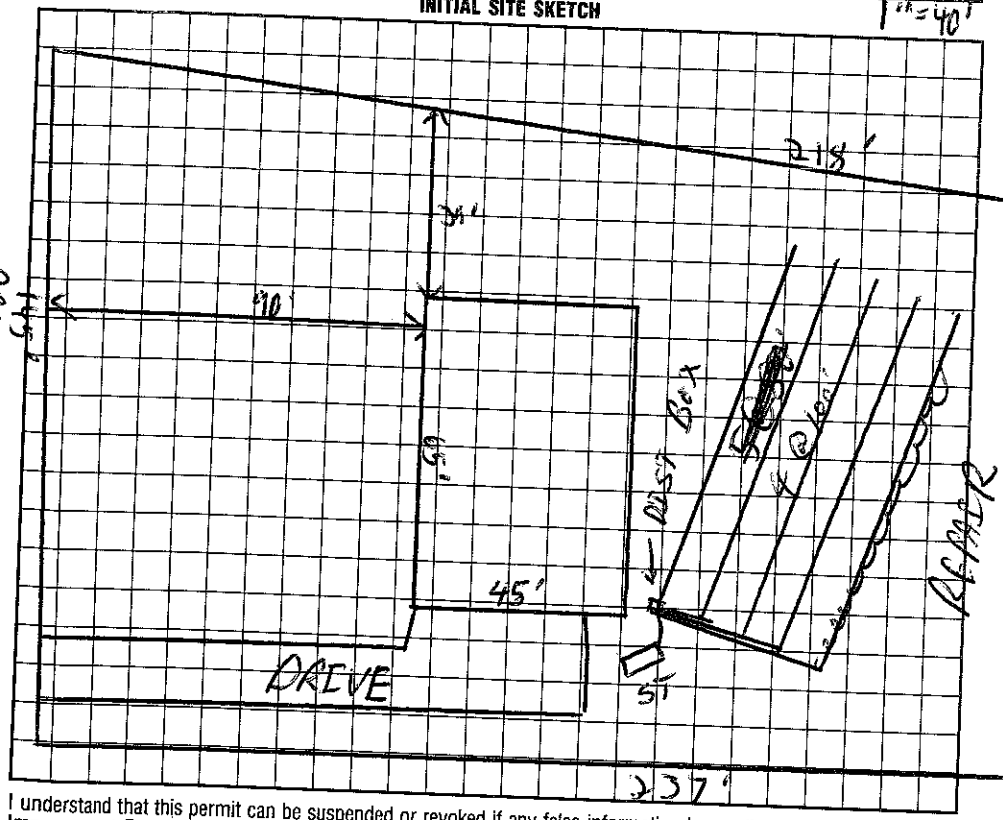

AS BUILT SKETCH

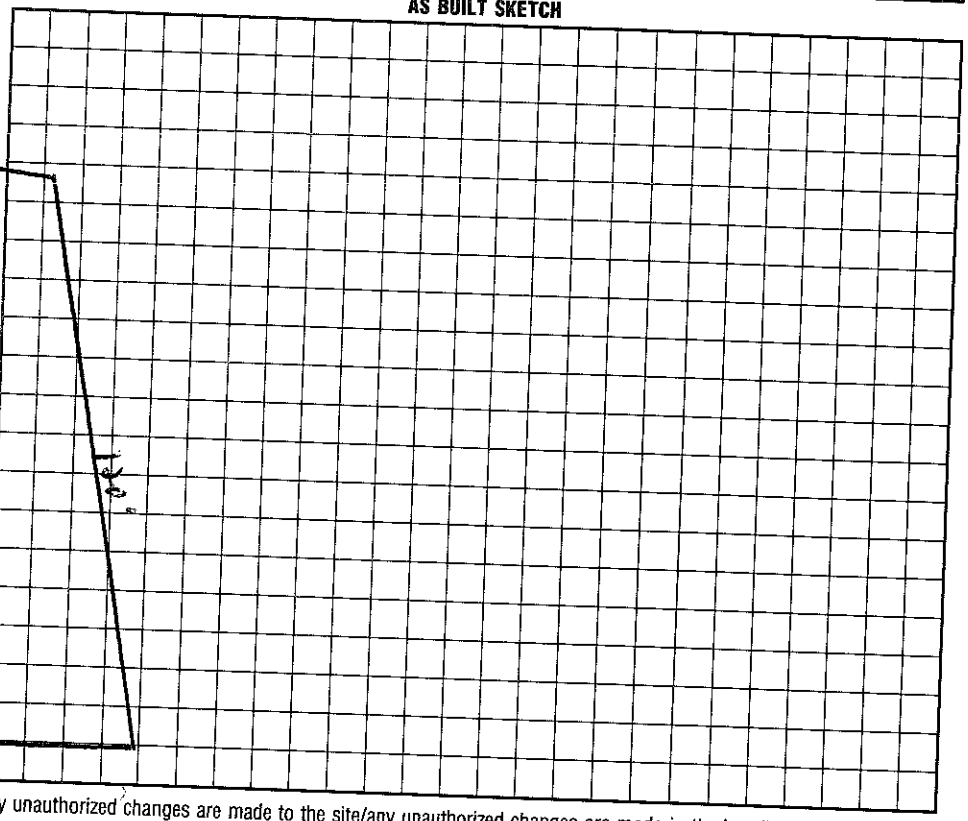

I understand that this permit can be suspended or revoked if any false information is supplied toward securing the permit/any unauthorized changes are made to the site/any unauthorized changes are made in the installation of the system. Improvement Permit is valid for 60 months from date of issuance.

Signed: Ron Baker for Milestone Bldrs

Improvement Permit by: C Ray Freeman date 4/11/97

~~Existing System Inspection by:~~ AUTHORIZATION TO CONSTRUCT C Ray Freeman date 4/11/97

Installed by: WAYNE CRONTZ

Certificate of Completion by: _____ date _____

Operation Permit by: C Ray Freeman date 11/4/97

HEALTH DEPT. COPY: WHITE INSPECTION COPY (FINAL): GREEN OWNER COPY (FINAL): YELLOW INSPECTION COPY (INITIAL): PINK OWNER COPY (INITIAL): GOLD