3:00

IREDELL COUNTY HEALTH DEPARTMENT

STATESVILLE 704-878-5305 MOORESVILLE 704-664-5281

IMPROVEMENT PERMIT / AUTHORIZATION TO CONSTRUCT / OPERATION PERMIT / EXISTING SYSTEM INSPECTION

PERMIT# 129955 PIN# 4636942447 DATE 6/17/08

OWNER OR APPLICANT Kent Shaw PHONE: Business 704.520.4421 Home 704.528.4414

ADDRESS P.O. Box 1061 Troutman, NC

LOCATION Brawley School Rd. ~~TL Broadbill~~, ~~TR~~ R. TL Canvasback, TL Broadbill, TR Ringneck, on Rt. #108 Ringneck

SUBDIVISION Woodland Hills BLOCK / SECTION 8 LOT 105 LOT AREA 6.663 acres SITE CLASS. P.S. DESIGN FLOW 360gal L.T.A.R. C.3

Septic Tank: 1000 Gallons: STB 1012 Date 11-1-07

Pump Tank: _____ Gallons: PT _____ Date _____

Pump Make: _____ Model _____ Serial No. _____

Nitrification Field: No Fields 1 Square Feet 1200 Linear Feet 300

No Lines 4 Trench Width 36" Max Trench Bottom Depth 36" Gravel Depth —

☑ New System ☐ Repair ☐ Expansion System Type: I II III IV V VI

System Description: gravity 25%

Repair System Description: pump/gravity panel block

Maintenance Agreement Required: ☐ Yes ☑ ~~No~~

☑ ~~House/Mod. Home~~ No. Bedrooms 3

☐ Mobile Home No. Persons ____

☐ Business No. Employees ____

☐ Other ____

Water Supply: ☐ Individual ☑ ~~Public~~ ☑ Community


☐ Gravity ☐ Pressure ☐ Slab ☑ ~~Crawl Space~~ ☐ Basement w/plumbing ☐ Basement wo/plumbing

Comments:/Conditions: - Install on contour, maintain all setbacks
- Mouse end cap dist. on infiltrator


Comments:/Conditions: 8/12/08 - Installed as drawn, used Quick 4 Used built in drop boxes.

1" = 40'

INITIAL SITE SKETCH

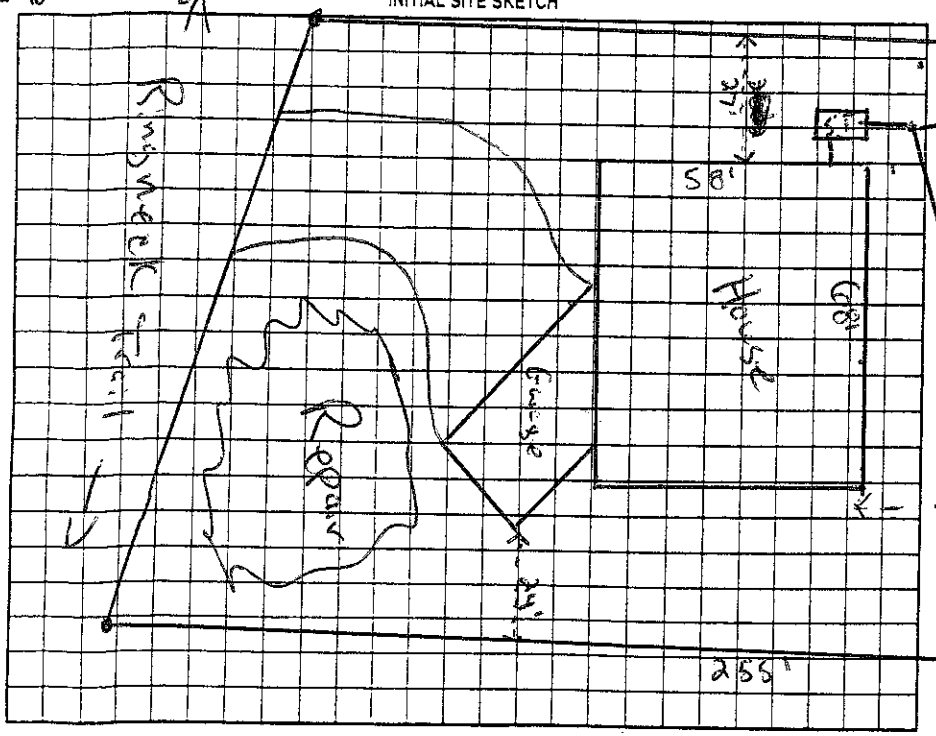

AS BUILT SKETCH

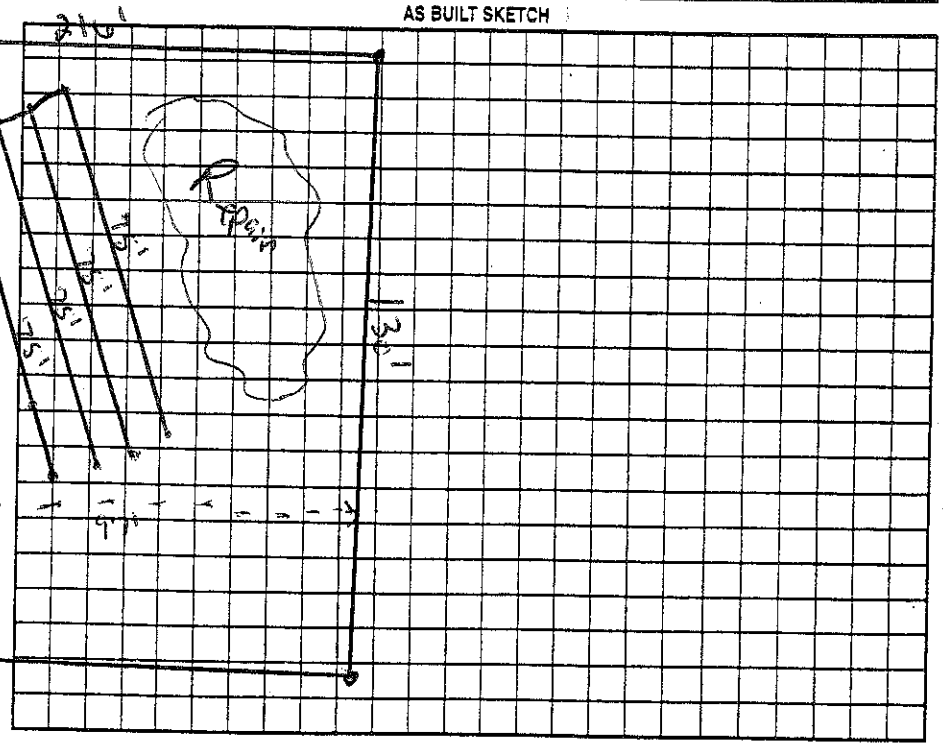

Permit can be suspended or revoked if any false information is supplied toward securing the permit/any unauthorized changes are made to the site/any unauthorized changes are made in the installation of the system. Improvement Permit with plat valid without expiration ☑ Improvement Permit with site plan valid for sixty months ☑ Authorization to Construct is valid for a period equal to that of Improvement Permit – not to exceed sixty months.

Signed: _____ date 6-18-08 Installed by: Craig Thompson

Improvement Permit by: _____ date 6/17/08 Operation Permit by: _____ date 8/12/08

Authorization to Construct by: _____ date 6/17/08 Existing System Inspection by: _____ date _____

HEALTH DEPT. COPY: WHITE OWNER COPY (FINAL): YELLOW OWNER COPY (INITIAL): PINK