IREDELL COUNTY HEALTH DEPARTMENT

AUTHORIZATION TO CONSTRUCT

STATESVILLE 704-878-5305 MOORESVILLE 704-664-5281

12" 875-4c

IMPROVEMENT PERMIT / ~~CERTIFICATE OF COMPLETION~~ / OPERATION PERMIT / EXISTING SYSTEM INSPECTI

PROPERTY DESCRIPTION NO. 25348 DATE 11/4/96 TAX MAP NO. 26-19-A-107 Watershed: ☑ Yes ☐ No

OWNER OR CONTRACTOR KEN KOONTZ PHONE: Business 4636944 2752 Home 662-6556

ADDRESS 191 KEATS RD MOORESVILLE

LOCATION BRAWLEY SCHOOL - TL CANVASBACK TL BROADBILL

SUBDIVISION WOODLAND HILLS BLOCK / SECTION 8 LOT 107 LOT AREA .614 AC SITE CLASS. PS DESIGN FLOW 360GPD L.T.A.R. .3 GPD/FT

Septic Tank: 1600 Gallons; STB 1017 Date 4/27/97

Pump Tank: _____ Gallons; PT _____ Date _____

Pump Make: _____ Model _____ Serial No. _____

Nitrification Field: No Fields 1 Square Feet 1200 Linear Feet 400

No Lines 4 Trench Width 36" Max Trench Bottom Depth 36" Gravel Depth 12"

☑ New System ☐ Repair System Type: I, II, III, IV, V, VI

System Description: GRAVITY CONVENTIONAL

Repair System Description: GRAVITY CHAMBERED

Maintenance Agreement Required: ☐ Yes ☑ No

☑ House/Mod. Home No. Bedrooms 3

☐ Mobile Home No. Bathrooms 2

☐ Business No. Employees ____

☐ Other _____


☐ Slab ☑ Crawl Space ☐ Basement w/plumbing ☐ Basement wo/plumbing

Water Supply: ☐ Individual ☑ Community ☐ Public

Comments:

Comments:

INITIAL SITE SKETCH 1"=50'

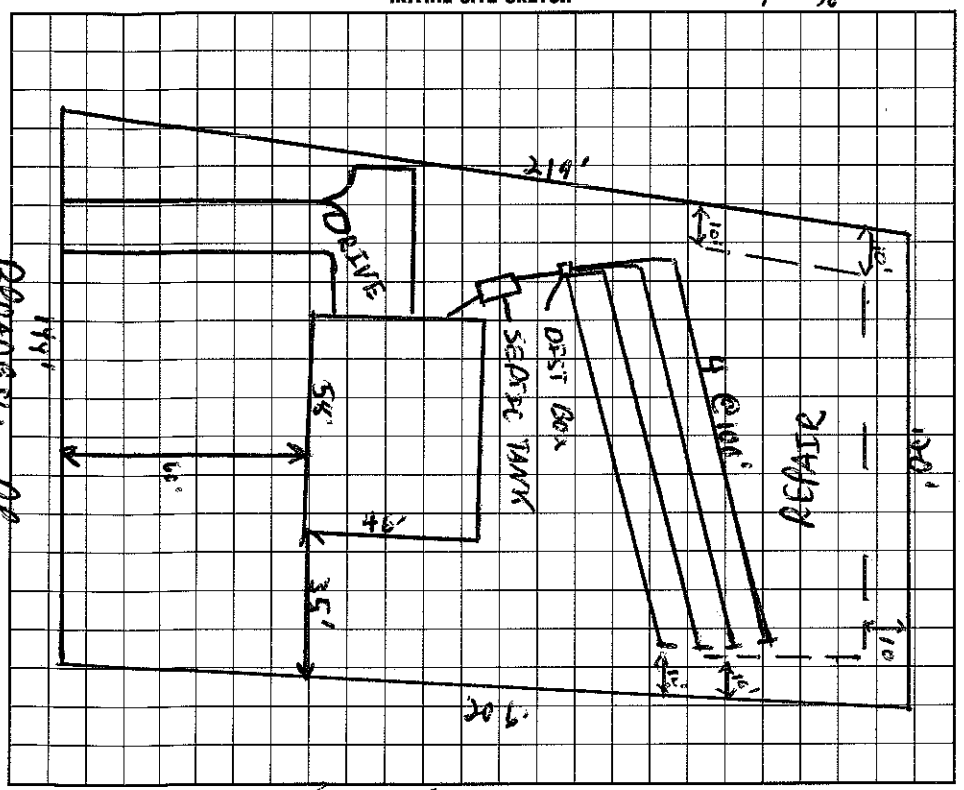

AS BUILT SKETCH

I understand that this permit can be suspended or revoked if any false information is supplied toward securing the permit/any unauthorized changes are made to the site/any unauthorized changes are made in the installation of the system.

Signed: Ken Koontz

Improvement Permit by: C. Ray Teem EHSI date 11/4/96

AUTHORIZATION TO CONSTRUCT ~~Existing System Inspection by~~: C. Ray Teem EHSI date 11/4/96

Installed by: Thompsons Earthworks

Certificate of Completion by: Wesley Sparks RS. date 6/24/97

Operation Permit by: Wesley Sparks RS. date 6/24/97

HEALTH DEPT. COPY: WHITE INSPECTION COPY (FINAL): GREEN OWNER COPY (FINAL): YELLOW INSPECTION COPY (INITIAL): PINK OWNER COPY (INITIAL): GOLD