IREDELL COUNTY HEALTH DEPARTMENT

STATESVILLE 704-878-5305 MOORESVILLE 704-664-5281

IMPROVEMENT PERMIT / CERTIFICATE OF COMPLETION / OPERATION PERMIT / EXISTING SYSTEM INSPECTION

PROPERTY DESCRIPTION NO. 20596 DATE 3/30/95

OWNER OR CONTRACTOR Scott Boyer TAX MAP NO. 2G 19A 106

ADDRESS 109 Nista Ln. Huntersville, NC. 28078 PHONE: Business Home 875-3443 Watershed: ☐ Yes ☑ No

LOCATION Corner Broadbill Dr. - Ringneck Trail 4636 94 3508

SUBDIVISION Woodland Hills BLOCK / SECTION 8 LOT 106 LOT AREA .979 SITE CLASS. P DESIGN FLOW 360 L.T.A.R. .35

Septic Tank: 1000 Gallons; STB 794 Date 1/24/96

Pump Tank: Gallons; PT Date

Pump Make: Model Serial No.

Nitrification Field: No Fields 1 Square Feet 1028 Linear Feet 345

No Lines 3 Trench Width 36" Max Trench Bottom Depth 30" Gravel Depth 12"

☑ New System ☐ Repair System Type: I, (II) III, IV, V, VI

System Description: CONV - DIST BOX

Repair System Description: CONV -

Maintenance Agreement Required: ☐ Yes ☑ No

☑ House/Mod. Home ☐ Mobile Home ☐ Business ☐ Other

No. Bedrooms 3 No. Bathrooms 2 No. Employees


☐ Slab ☑ Crawl Space ☐ Basement w/plumbing ☐ Basement wo/plumbing

Water Supply: ☐ Individual ☑ Community ☐ Public


Comments: Trenches on slope contour - in direction shown

Comments: Installed as shown.

INITIAL SITE SKETCH

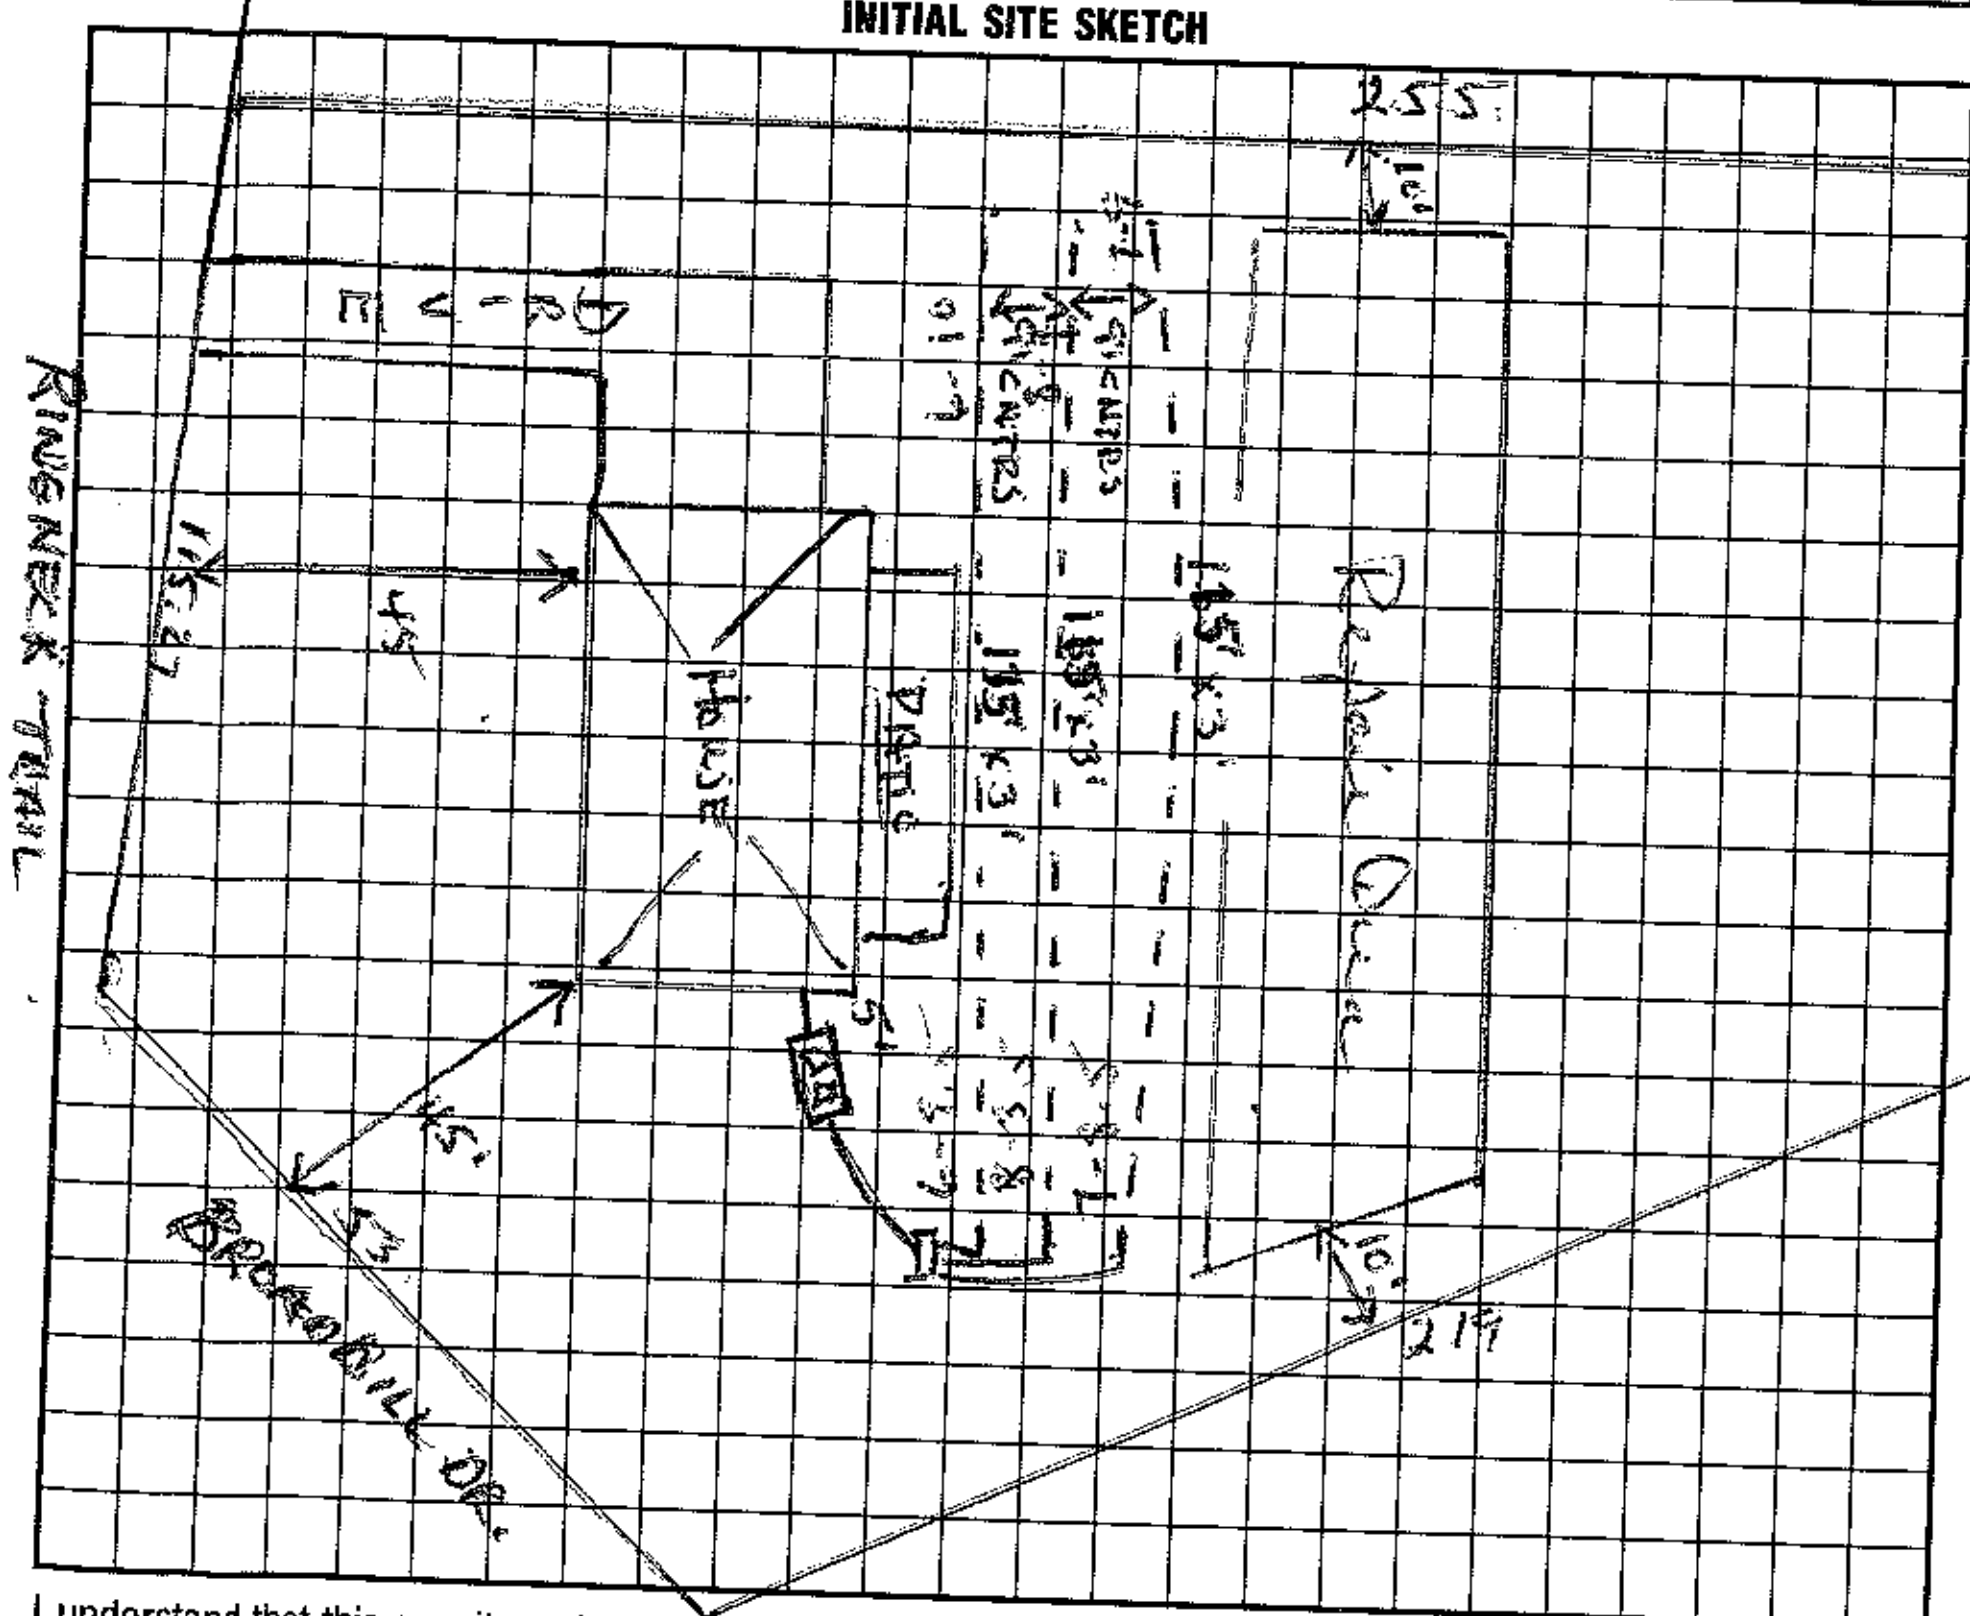

AS BUILT SKETCH

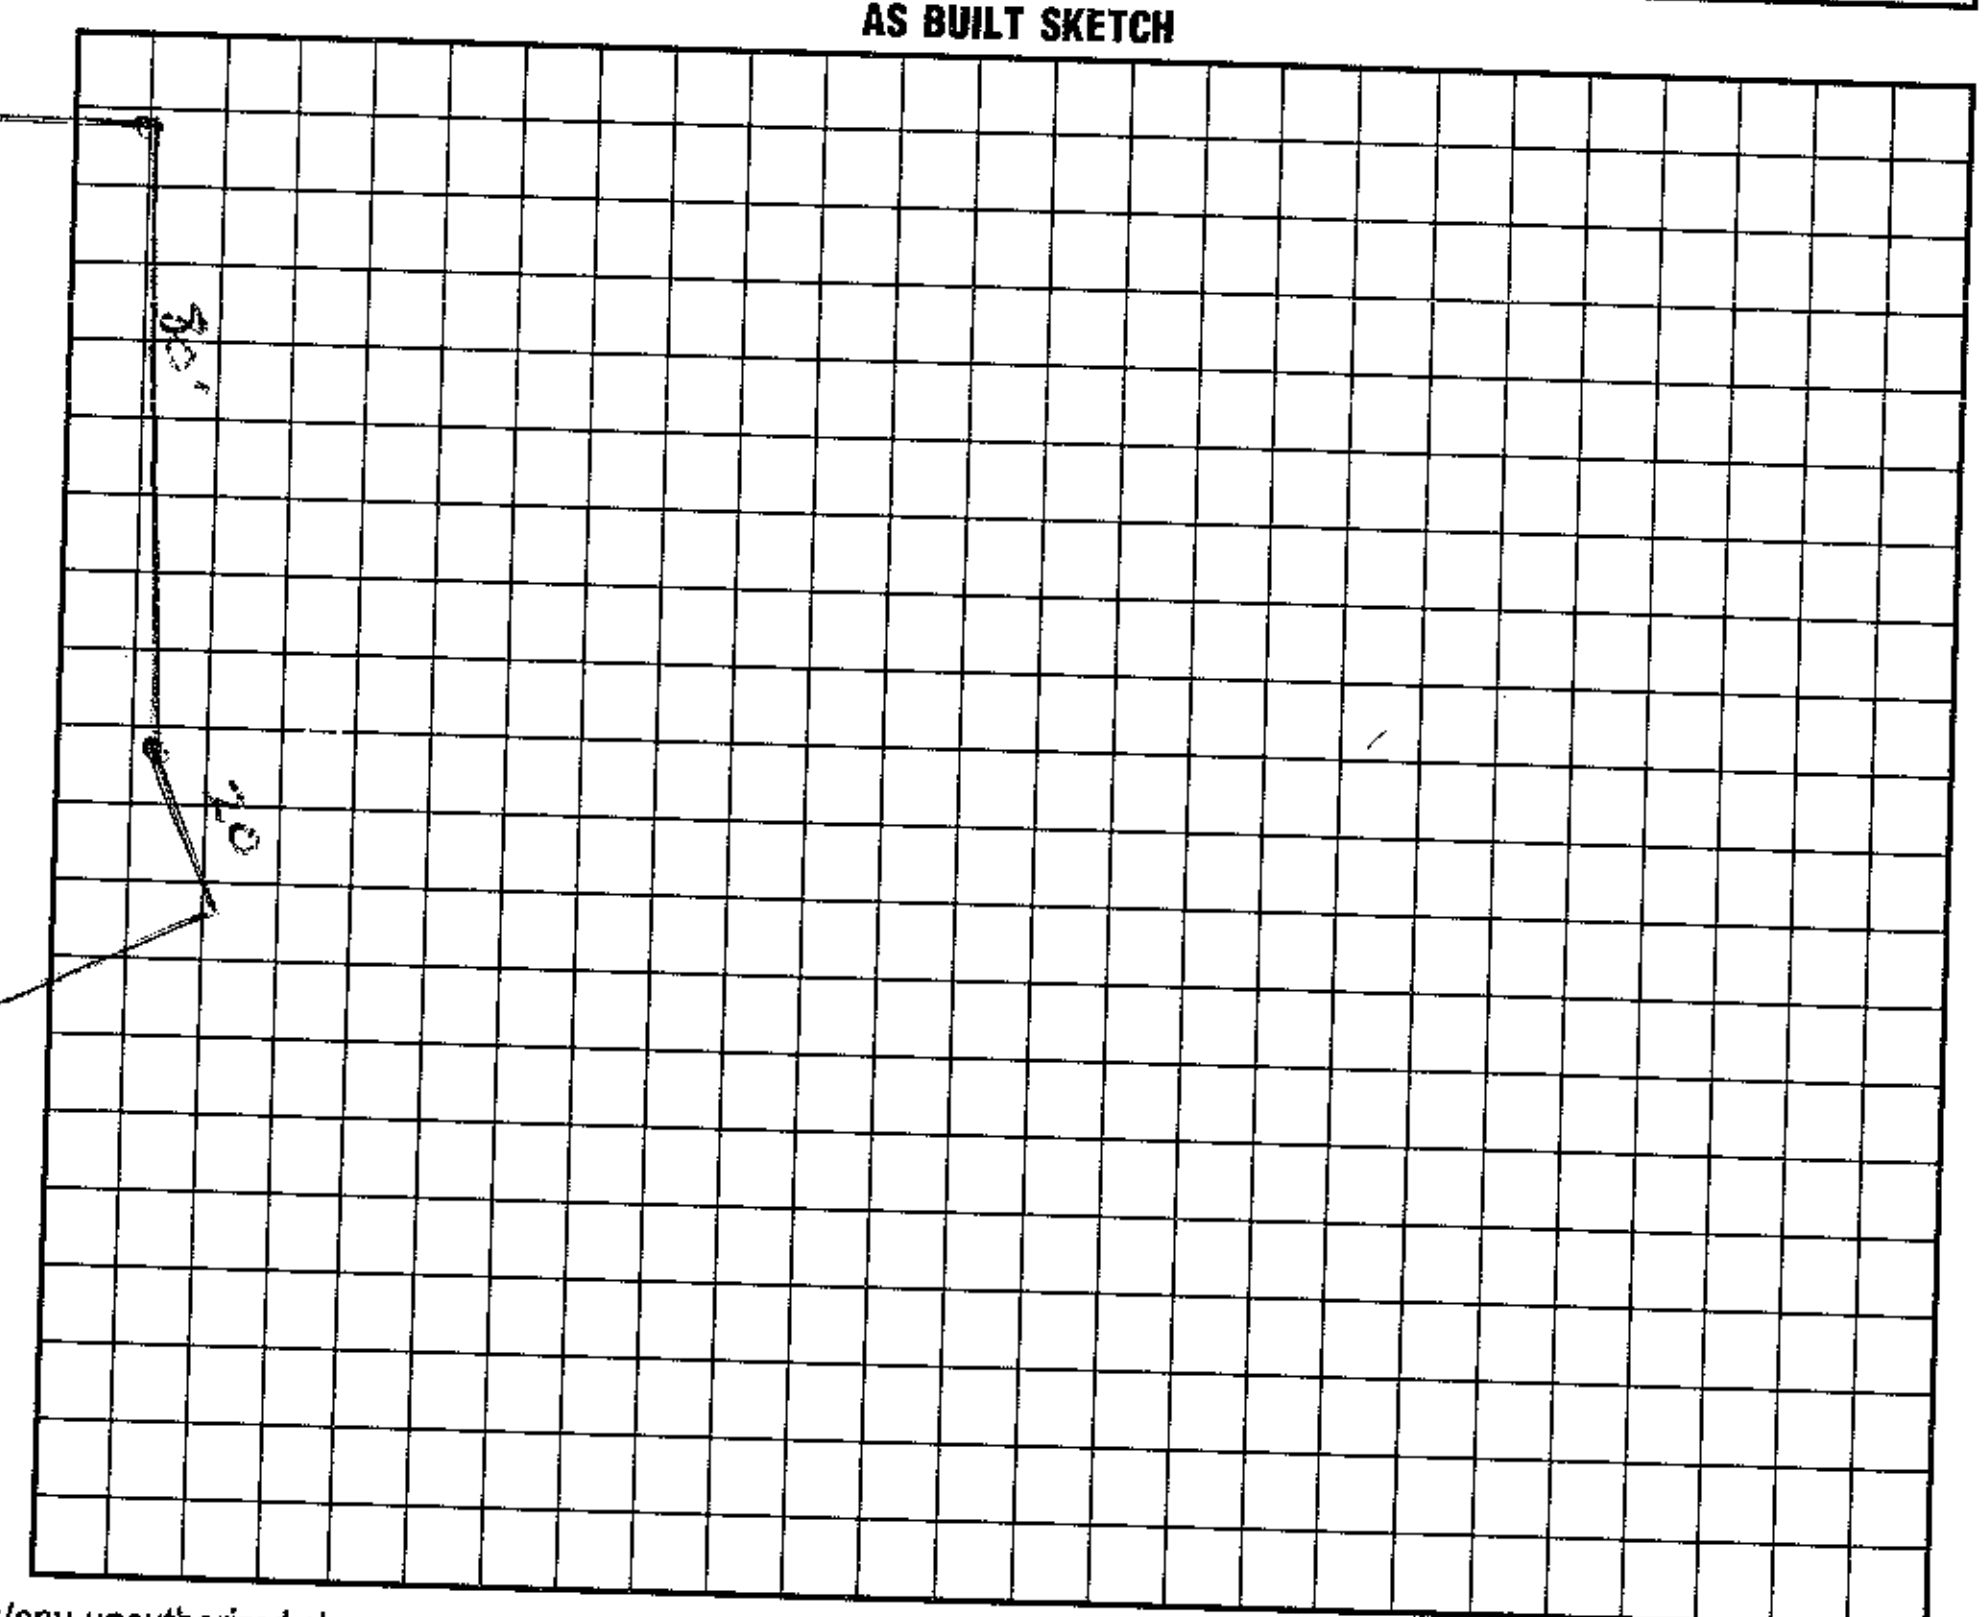

I understand that this permit can be suspended or revoked if any false information is supplied toward securing the permit/any unauthorized changes are made to the site/any unauthorized changes are made in the installation of the system. Improvement Permit is valid for 60 months from date of issuance.

Signed: [signature] 3-30-95

Improvement Permit by: Wesley Sparks R.S. date 3/30/95

Existing System Inspection by: date

Installed by: F J Ervin

Certificate of Completion by: date

Operation Permit by: Wesley Sparks R.S. date 4/25/96

HEALTH DEPT. COPY: WHITE INSPECTION COPY (FINAL): GREEN OWNER COPY (FINAL): YELLOW INSPECTION COPY (INITIAL): PINK OWNER COPY (INITIAL): GOLD