IREDELL COUNTY HEALTH DEPARTMENT

STATESVILLE 704-878-5305 MOORESVILLE 704-664-5281

IMPROVEMENT PERMIT / AUTHORIZATION TO CONSTRUCT / OPERATION PERMIT / EXISTING SYSTEM INSPECTION

PERMIT # 16137 PIN # 4636-94-3508 DATE 6-25-10

OWNER or APPLICANT SCOTT BOYER PHONE: Business 704-491-2289 Home:

OWNER or APPLICANT ADDRESS 154 BROADSILL DRIVE

LOCATION / DIRECTIONS BSR, TL CANVASBACK, TL BROADSILL, 154

SUBDIVISION WOODLAND HILLS BLOCK / SECTION 8 LOT # 106 LOT AREA .98 AC DESIGN FLOW 360 GPD L.T.A.R.

Septic Tank Ex 1000 Gallons: STB Date

Pump Tank Gallons: P T Date

Pump Make Model Serial #

Nitrification Field No Fields 1 No Lines 3 Linear Feet 360'

Trench Width 36" Max. Trench Bottom Depth >36" Gravel Depth

☐ New System ☐ Repair ☐ Expansion System Type I II III IV V VI

System Description: Ex. GRAVITY GRAVEL

Repair System Description: GRAVITY 25% REDUCTION

Maintenance Agreement Required ☐ YES ☒ NO

☒ GRAVITY ☐ PRESSURE


☒ Residence No. Bedrooms 3 ☐ Business No. Persons ☐ Other No. Employees ☐ Slab ☒ Crawl Space ☐ Basement w/plumbing ☐ Basement w/o plumbing

Water Supply: ☐ Private ☐ Public ☒ Community


Comments / Conditions 1) NO PART OF FOUNDATION CAN BE WITHIN 5' FROM THE SEPTIC FIELD 2) SYSTEM LOOKS GOOD @ TIME OF INSPECTION

Comments / Conditions GARAGE

INITIAL SITE SKETCH

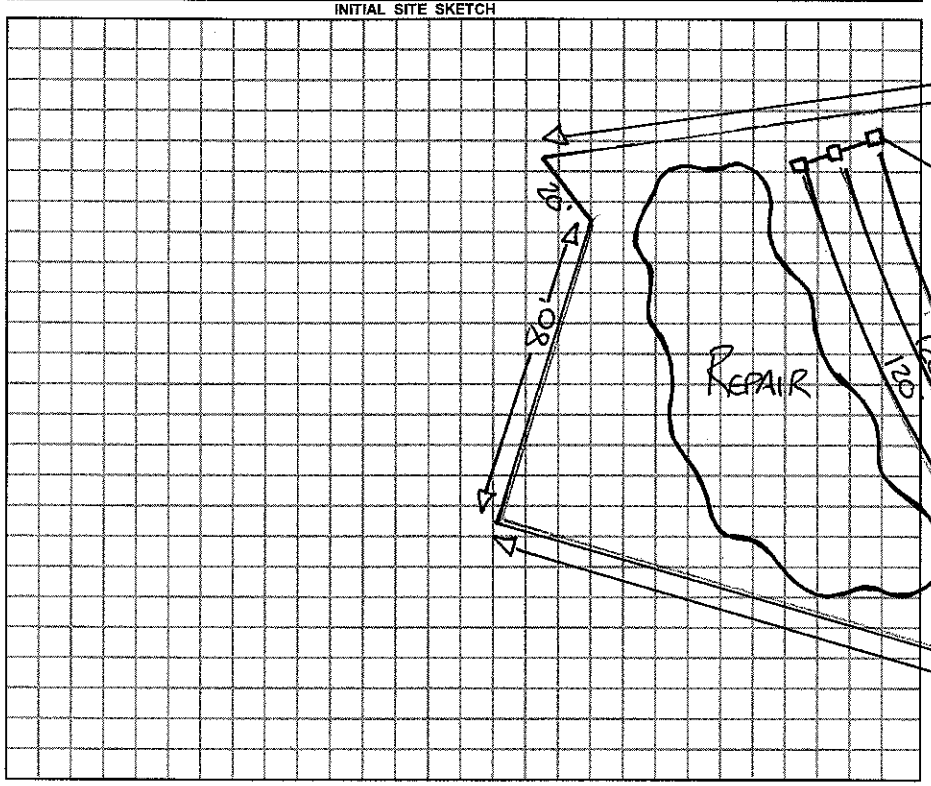

AS BUILT SKETCH

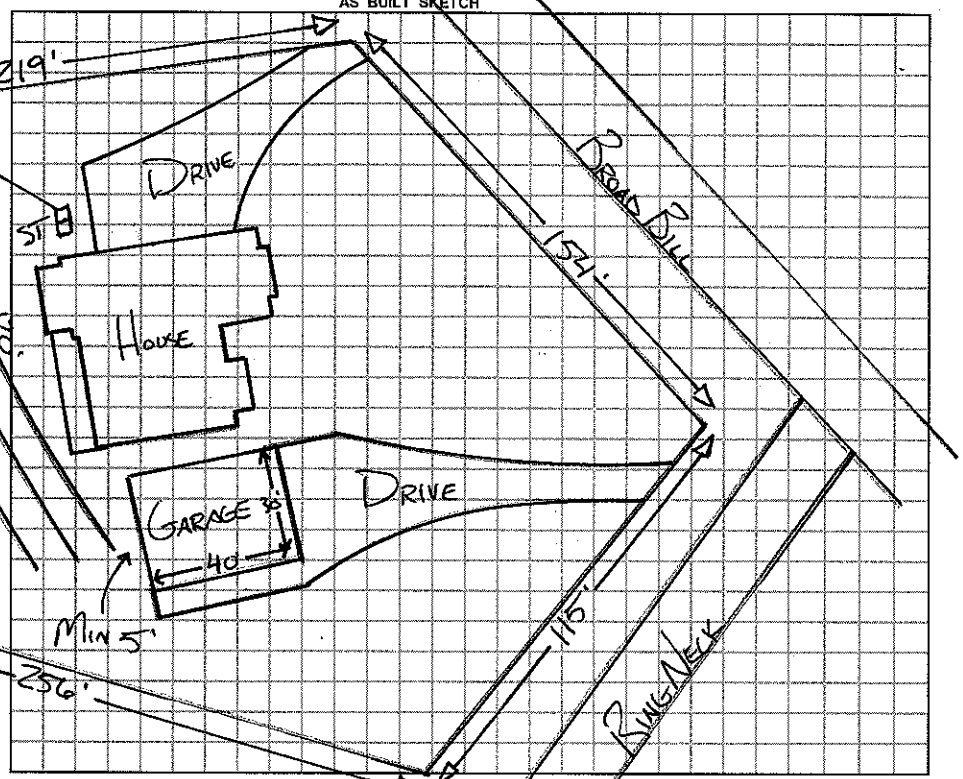

Permit can be suspended or revoked if any false information is supplied toward securing the permit / any unauthorized changes are made to the site / any unauthorized changes are made in the installation of the system.

☐ *IMPROVEMENT PERMIT w / plat valid without expiration.* ☐ *IMPROVEMENT PERMIT w / site plan valid for 60 mos.* ☐ *AUTHORIZATION TO CONSTRUCT valid for period equal to IMPROVEMENT PERMIT-not to exceed 60 mo.*

Owner / Applicant Signature: B Campbell for S. Boyer Date 6/29/10

Improvement Permit by: Date

Authorzation to Construct by: Date

YOU SHOULD CONTACT A LOCATOR SERVICE PRIOR TO ANY EXCAVATION.

Installed by:

Operation Permit by: Date:

Existing System Inspected by: REHS Date: 6-25-10

WHITE COPY Environmental Health YELLOW COPY (Final) Owner / Applicant PINK COPY (Initial) Owner / Applicant