IREDELL COUNTY HEALTH DEPARTMENT

Authorization to Construct 4636 94 5081

STATESVILLE 704-878-5305 MOORESVILLE 704-664-5281

IMPROVEMENT PERMIT / ~~CERTIFICATE OF COMPLETION~~ / OPERATION PERMIT / EXISTING SYSTEM INSPECTION

PROPERTY DESCRIPTION NO. 21605 DATE 6/25/96 TAX MAP NO. 2G 19A 86 Watershed: [X] Yes [ ] No

OWNER OR CONTRACTOR Rusty Roberts PHONE: Business _____ Home 548-0059

ADDRESS 8309 Norcroft Dr. Chen. NC. 28269

LOCATION Ring Neck Trail, Brawley TL Commons back TL Broadbill TR Ring Neck TL 3RD lot on (L)

SUBDIVISION Mallard Head BLOCK / SECTION _____ LOT 86 LOT AREA .6 AC SITE CLASS. 0 PS DESIGN FLOW 480 L.T.A.R. .3

Septic Tank: 1000 Gallons; STB 794 Date 11/7/96

Pump Tank: 1000 Gallons; PT _____ Date _____

Pump Make: ZOELLER Model E-14OA Serial No. _____

Nitrification Field: No Fields 1 Square Feet 1600 Linear Feet 266

No Lines 4 Trench Width 24" Max Trench Bottom Depth 36" Gravel Depth 6" SAND

[X] New System [ ] Repair System Type: I, II, III, (IV), V, VI

System Description: Prefab Panel-Pressure

Repair System Description: Same

Maintenance Agreement Required: [X] Yes [ ] No

[X] House/Mod. Home No. Bedrooms 4

[ ] Mobile Home No. Bathrooms 4

[ ] Business No. Employees _____

[ ] Other _____


[ ] Slab [ ] Crawl Space [X] Basement w/plumbing [ ] Basement wo/plumbing

Water Supply: [ ] Individual [ ] Community [X] Public


Comments: 9/4/97 Authorized change to 4 lines -RS

Comments:

INITIAL SITE SKETCH

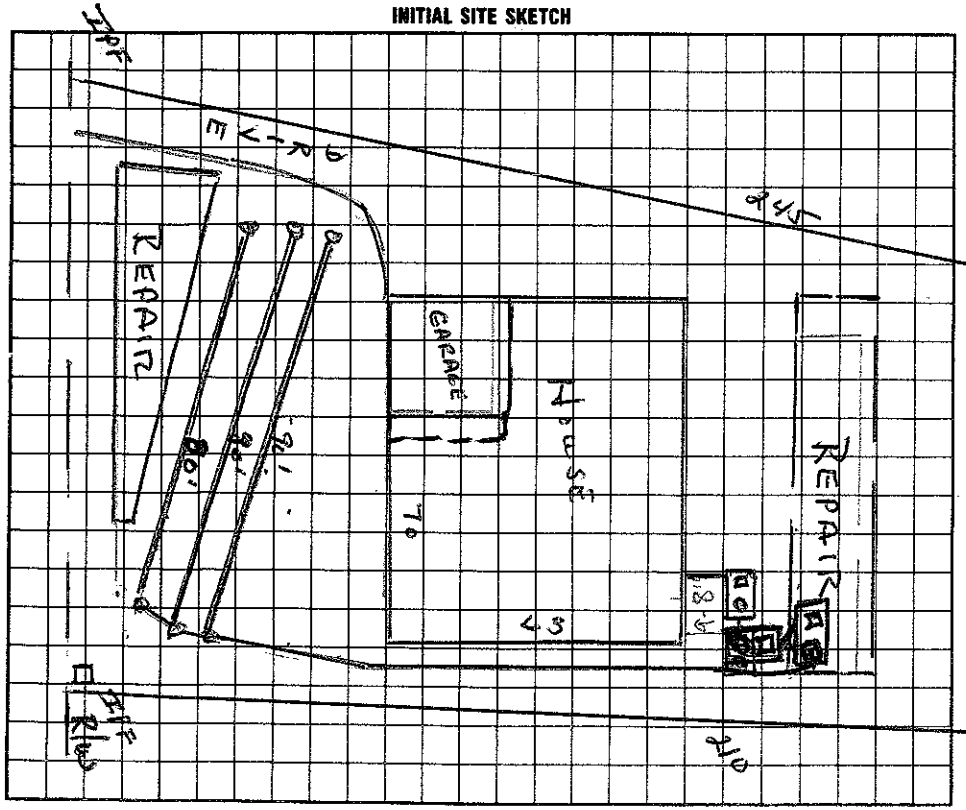

AS BUILT SKETCH

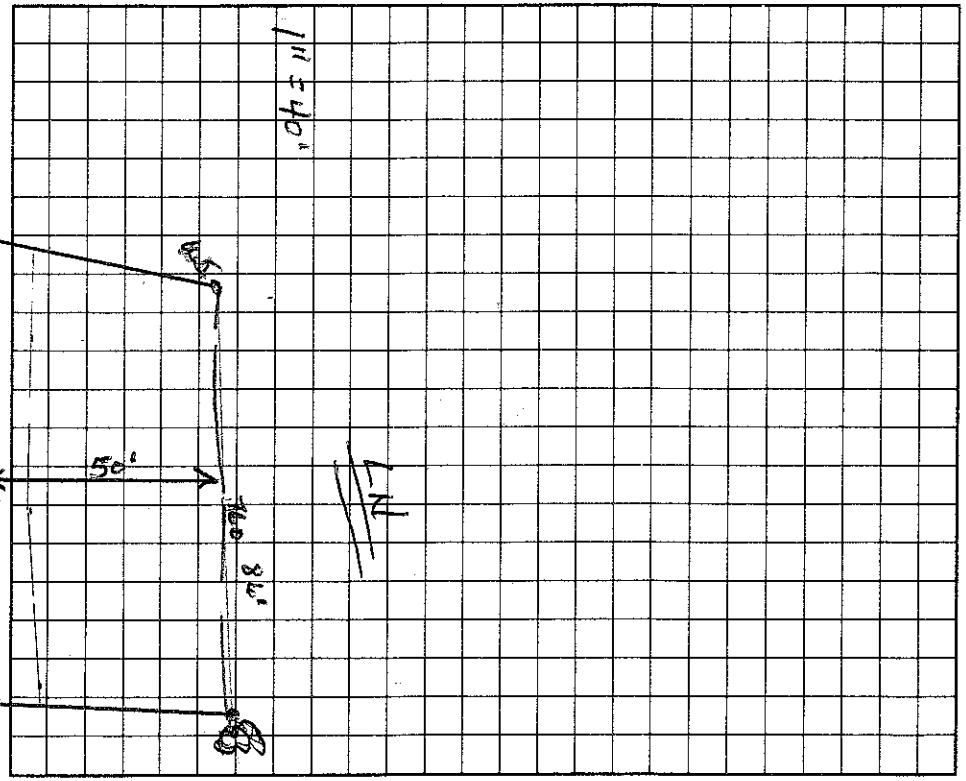

I understand that this permit can be suspended or revoked if any false information is supplied toward securing the permit/any unauthorized changes are made to the site/any unauthorized changes are made in the installation of the system.

Signed: Rusty Roberts

Improvement Permit by: Wesley Sparks R.S. date 6/25/96

~~Existing System Inspection by~~ Authorization to Construct Wesley Sparks R.S. date 6/25/96

Installed by: Tim Commons

Certificate of Completion by: Wesley Sparks R.S. date 9/29/97

Operation Permit by: Wesley Sparks R.S. date 9/29/97

HEALTH DEPT. COPY: WHITE INSPECTION COPY (FINAL): GREEN OWNER COPY (FINAL): YELLOW INSPECTION COPY (INITIAL): PINK OWNER COPY (INITIAL): GOLD