IREDELL COUNTY HEALTH DEPARTMENT

STATESVILLE 704-878-5305 Ø MOORESVILLE 704-664-5281

IMPROVEMENT PERMIT / AUTHORIZATION TO CONSTRUCT / OPERATION PERMIT / EXISTING SYSTEM INSPECTION

PERMIT# 14188 PIN# ~~4636-95-5388.009~~ 4636946940

OWNER OR CONTRACTOR Toland-Brown Const. PHONE: Business 704 361 1644 Home DATE 5/20/05

ADDRESS 19550 Weavers Cir

LOCATION BSR, TL Canvasback, TL Mandarin, on Rt, 9th Lot

SUBDIVISION Woodland Hills BLOCK / SECTION 10 LOT 9 LOT AREA SITE CLASS. PS DESIGN FLOW 480 L.T.A.R. 0.3

Septic Tank: 1000 Gallons; STB 794 Date 7/26/04

Pump Tank: Gallons; PT Date

Pump Make: Model Serial No.

Nitrification Field: No Fields 1 Square Feet 1200 Linear Feet 400

No Lines 8 Trench Width 36" Max Trench Bottom Depth 36" Gravel Depth —

☒ New System ☐ Repair System Type: ☐ II ☐ III, IV, V, VI

System Description: Gravity 25% Accepted Sys.

Repair System Description: Same

Maintenance Agreement Required: ☐ Yes ☒ No

☒ House/Mod. Home ☐ Mobile Home ☐ Business ☐ Other

No. Bedrooms 4 No. Bathrooms No. Employees

☐ Slab ☒ Crawl Space ☐ Basement w/plumbing ☐ Basement wo/plumbing


Water Supply: ☐ Individual ☐ Public ☒ Community

Comments:/Conditions:


Comments:/Conditions:

Quick 4 Infiltrators Installed

INITIAL SITE SKETCH

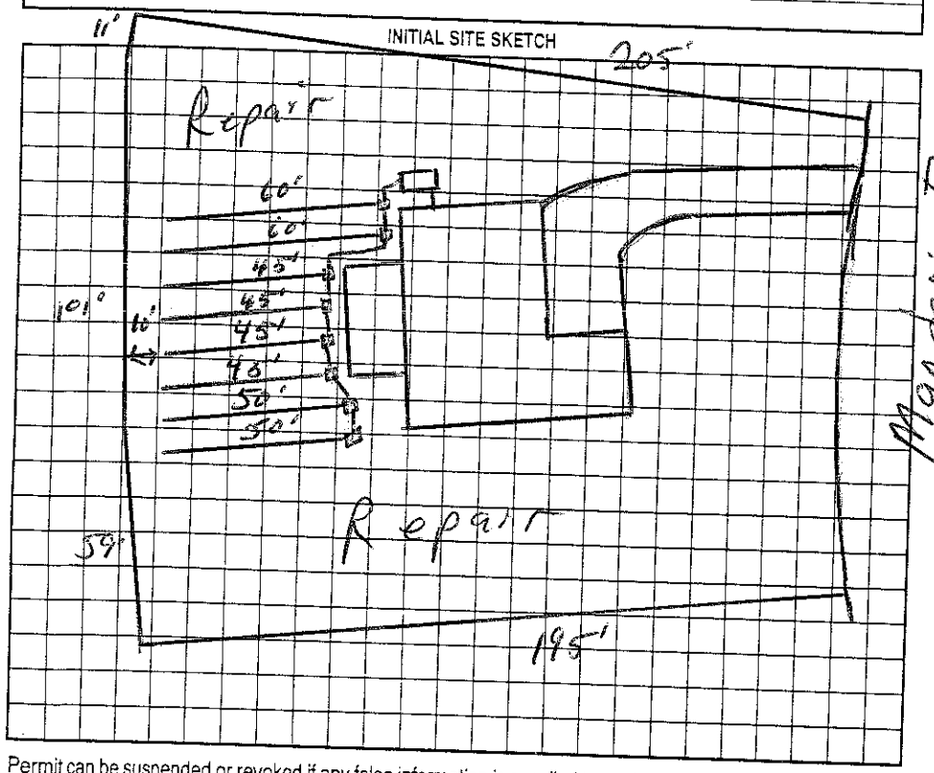

AS BUILT SKETCH

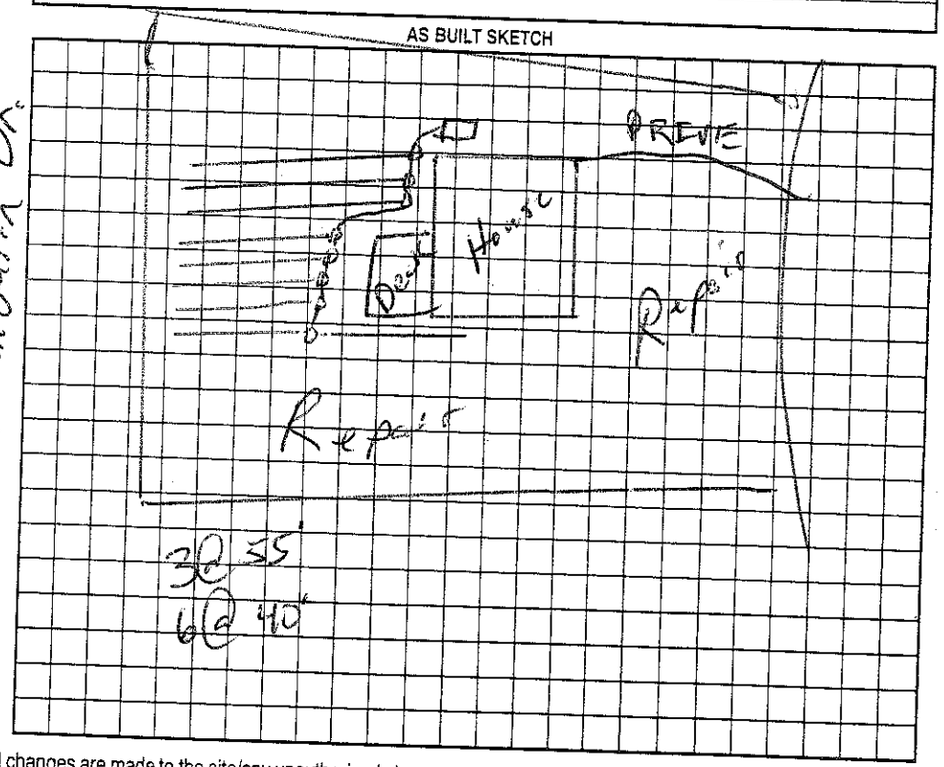

Permit can be suspended or revoked if any false information is supplied toward securing the permit/any unauthorized changes are made to the site/any unauthorized changes are made in the installation of the system. Improvement Permit with plat valid without expiration. Improvement Permit with site plan valid for sixty months. Authorization to Construct is valid for a period equal to that of Improvement Permit – not to exceed sixty months.

Signed: [signature] date 5/20/05 Installed by: Abernathy

Improvement Permit by: [signature] RS date 5/20/05 Operation Permit by: [signature] RS date 5/25/05

Authorization to Construct by: [signature] RS date 5/20/05 Existing System Inspection by: date

HEALTH DEPT. COPY: WHITE OWNER COPY (FINAL): YELLOW OWNER COPY (INITIAL): PINK