IREDELL COUNTY HEALTH DEPARTMENT

STATESVILLE 704-878-5305 MOORESVILLE 704-664-5281

IMPROVEMENT PERMIT / AUTHORIZATION TO CONSTRUCT / OPERATION PERMIT / EXISTING SYSTEM INSPECTION

PERMIT# 111984 PIN# 4636-95-5356.10 4636947748 DATE 4/21/03

OWNER OR CONTRACTOR [redacted] Spear Const. PHONE: Business 704 636-7454 Home

ADDRESS 607 Anderson Ave Salisbury NC 28144

LOCATION Brawley Sch, TL Canvasback, TL Mardarin Ct. on Rt. Near End

SUBDIVISION Woodland Hills BLOCK / SECTION 10 LOT 10 LOT AREA 0.69AC SITE CLASS PS DESIGN FLOW 480 L.T.A.R. 0.3

Septic Tank: 1000 Gallons; STB 825 Date 4/11/04

Pump Tank: Gallons; PT Date

Pump Make: Model Serial No.

Nitrification Field: No Fields 1 Square Feet 1605 Linear Feet 535

No Lines 5 @ 107' Trench Width 36" Max Trench Bottom Depth 36" Gravel Depth 12"

☒ New System ☐ Repair System Type: I, II, III, IV, V, VI

System Description: Gravity Conventional

Repair System Description: Pump 250 Gal

Maintenance Agreement Required: ☐ Yes ☒ No

☒ House/Mod. Home ☐ Mobile Home ☐ Business ☐ Other

No. Bedrooms 4 No. Bathrooms 4 No. Employees


☐ Slab ☒ Crawl Space ☐ Basement w/plumbing ☐ Basement wo/plumbing

Water Supply: ☐ Individual ☐ Public ☒ Community

Comments:/Conditions: Cont'd

Comments:/Conditions: 6/24/04 - Phone conversation with Johnny Spear authorizing removal of Infiltrator and paying of additional $130.00 fee. AWS

INITIAL SITE SKETCH

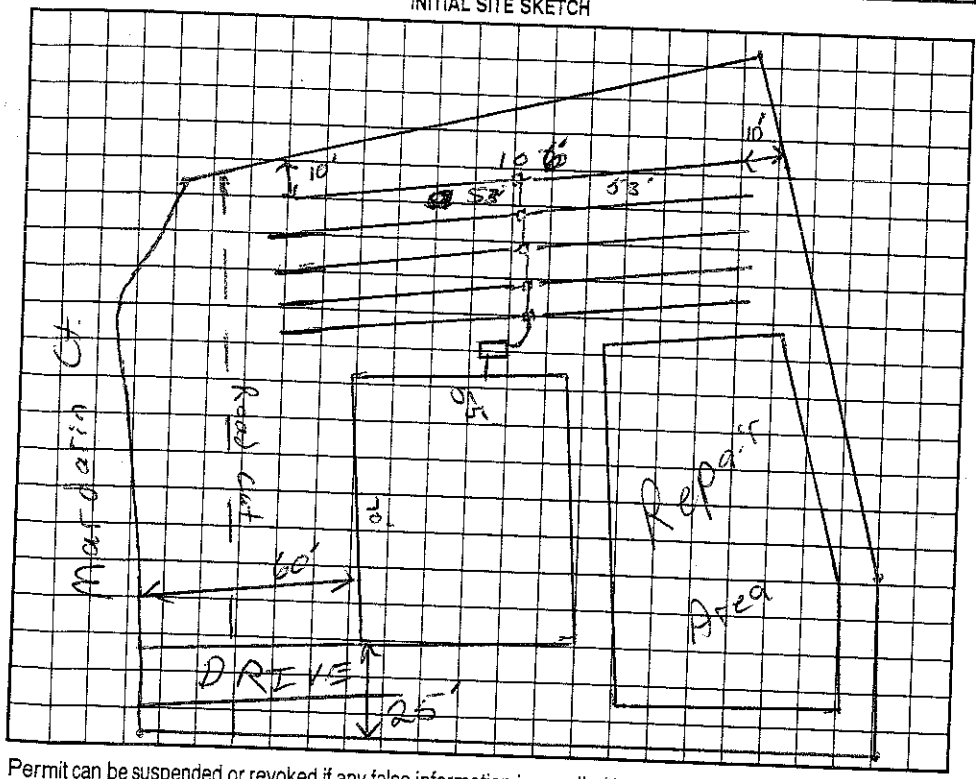

AS BUILT SKETCH

Permit can be suspended or revoked if any false information is supplied toward securing the permit/any unauthorized changes are made to the site/any unauthorized changes are made in the installation of the system. Improvement Permit with plat valid without expiration. Improvement Permit with site plan valid for sixty months. Authorization to Construct is valid for a period equal to that of Improvement Permit – not to exceed sixty months.

Signed: [redacted] date 4/23/03

Improvement Permit by: RS date 4/21/03

Authorization to Construct by: RS date 3/1/04

Installed by: Rowan Septic Tank

Operation Permit by: Wesley Sparks R.S. date 6/24/04

Existing System Inspection by: date

HEALTH DEPT. COPY: WHITE OWNER COPY (FINAL): YELLOW OWNER COPY (INITIAL): PINK