
~~FIRST FLOOR HEATED SQ.FT.~~ ~~1447~~ 1514'2"
SECOND FLOOR HEATED SQ.FT. ~~1187~~ 1288'10"

TOTAL HEATED SQ.FT. ~~2614~~ 2803'.

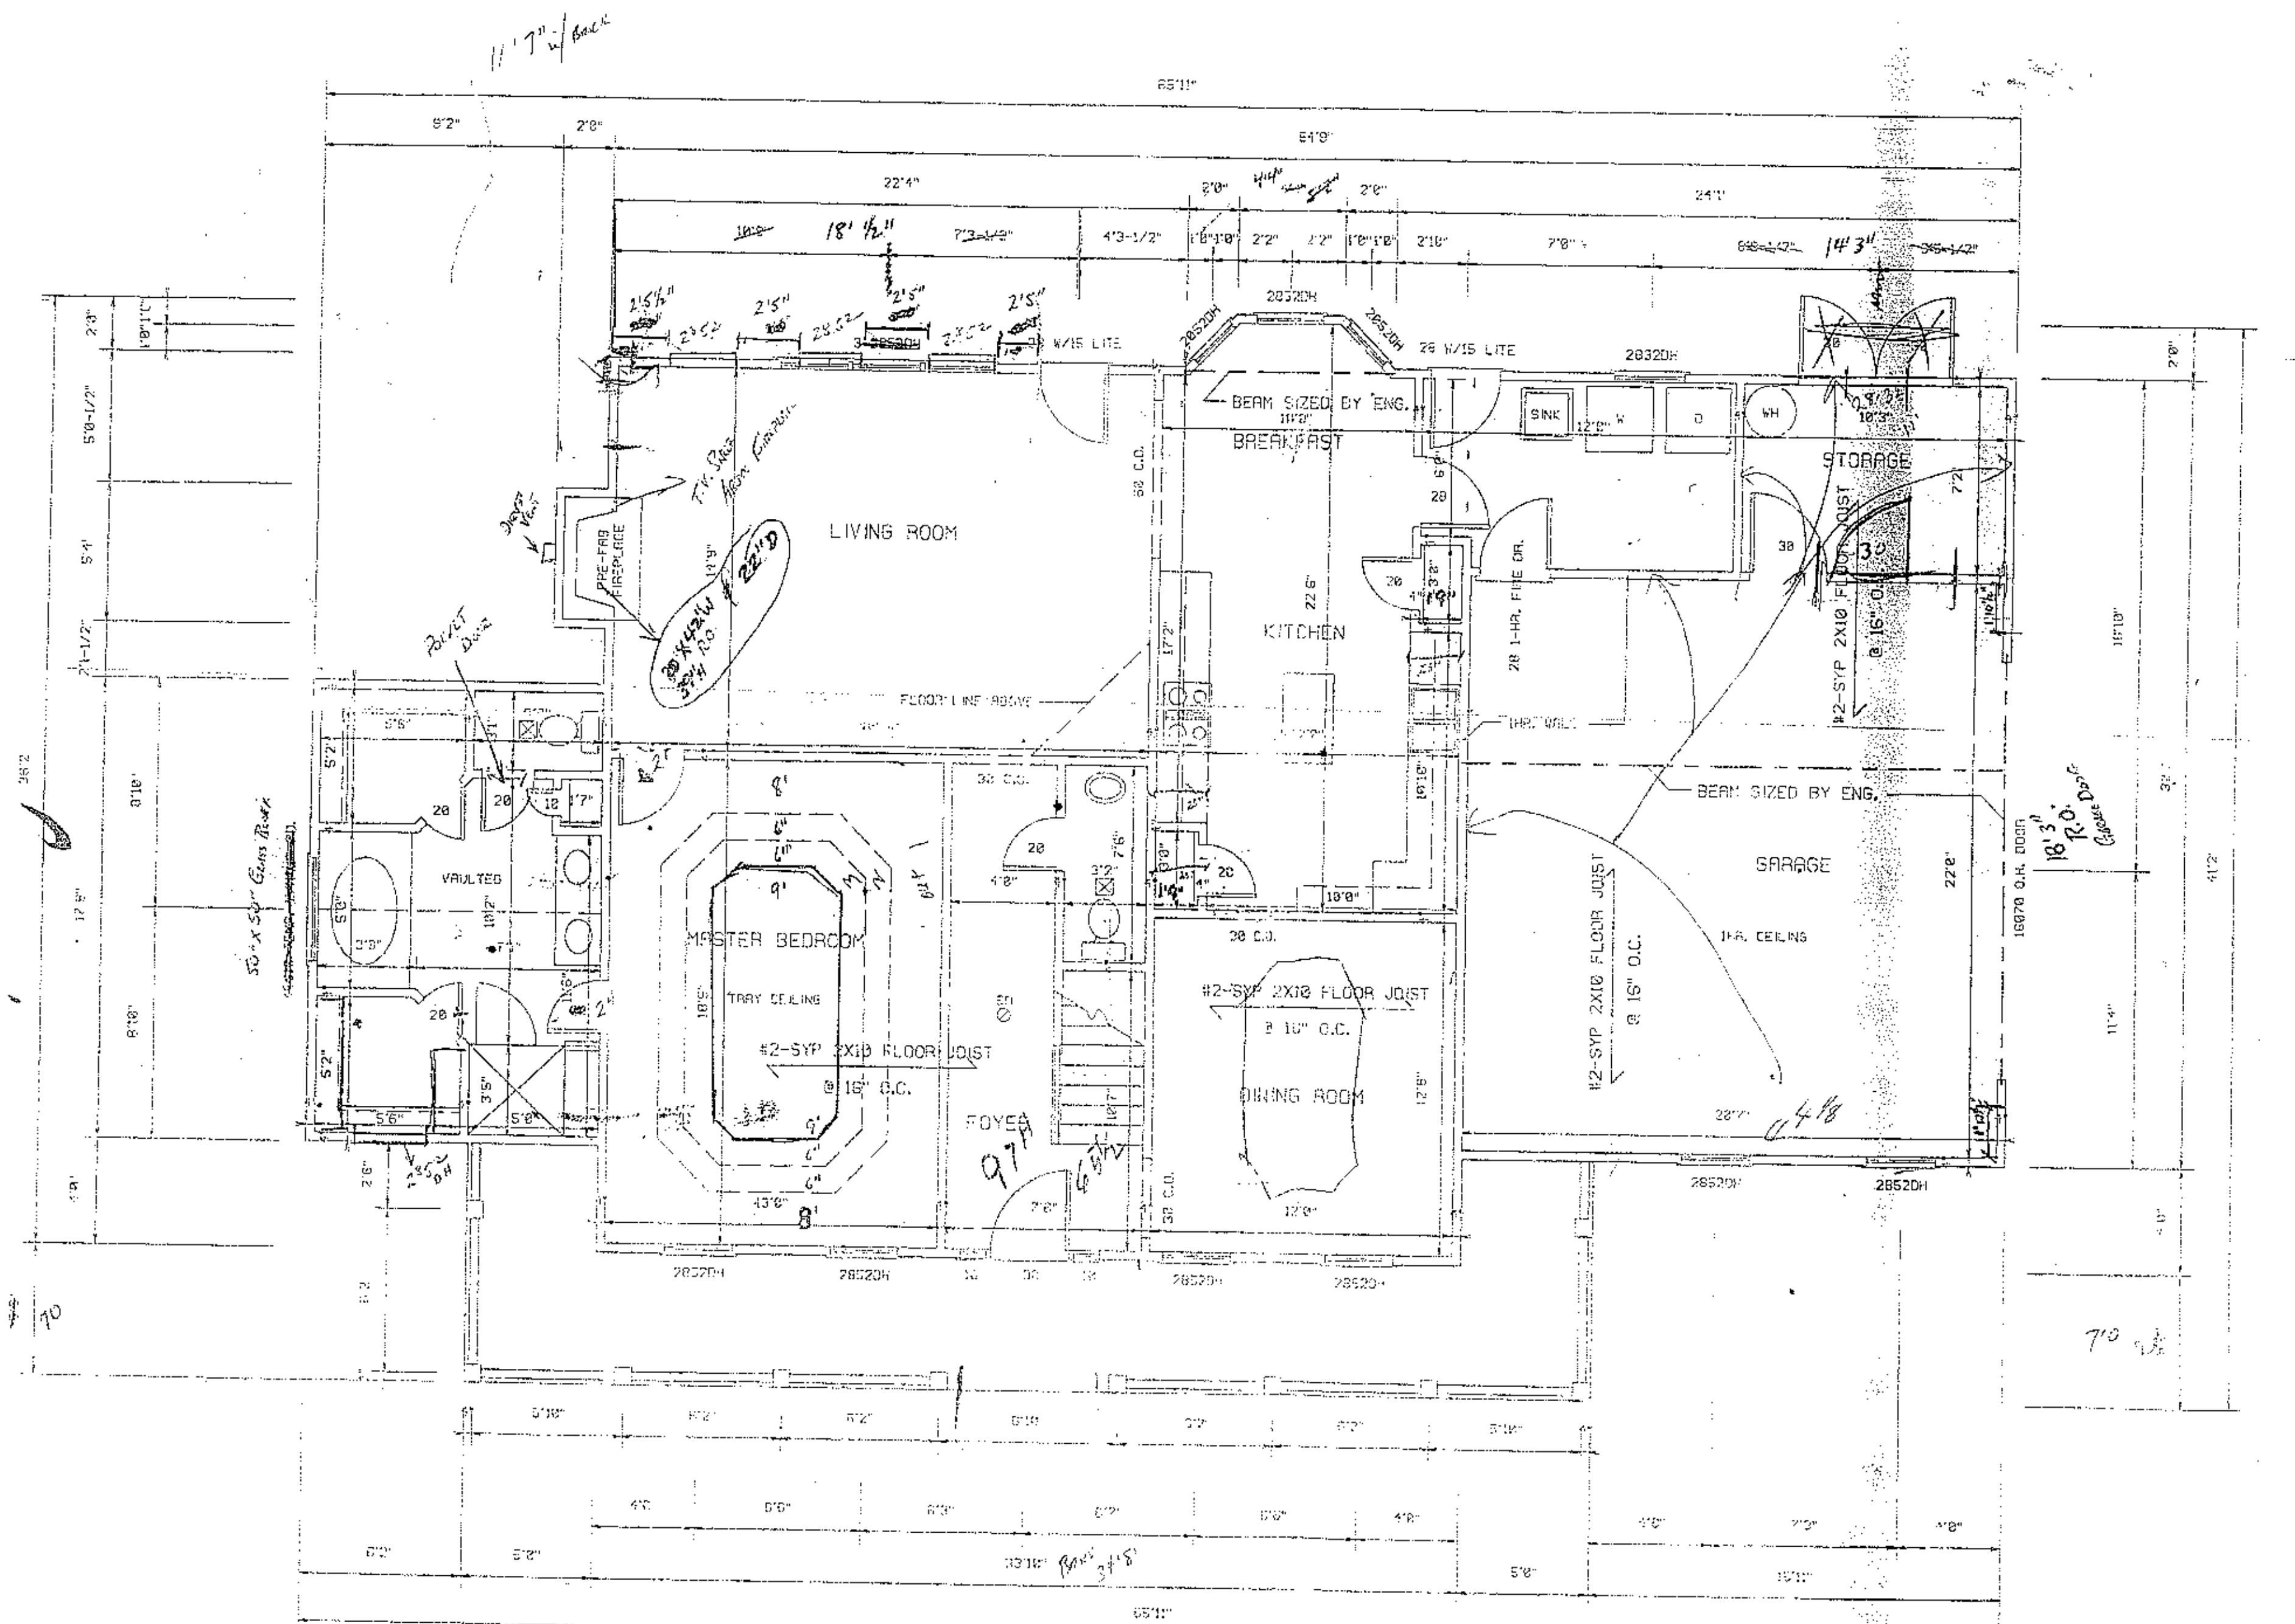

FIRST FLOOR PLAN

SCALE:1/4"=1'-0"

GENERAL NOTES:

(1) PLANS PROVIDED FOR LAYOUT AND DESIGN PURPOSES ONLY, IT SHALL BE THE GENERAL CONTRACTOR'S RESPONSIBILITY TO PROVIDE CERTIFIED ENGINEERING AS REQUIRED.
(2) CARRY ALL FOOTINGS TO FIRM UNDISTURBED BEARING BELOW FROST LINE, HAVE FOOTINGS DESIGNED BASED ON LOADS AND SOIL BEARING CAPACITY.
(3) GENERAL CONTRACTOR SHALL VERIFY ALL DIMENSIONS.
(4) ALL FEDERAL, STATE AND LOCAL CODES, ORDINANCES, REGULATIONS, ETC., SHALL BE CONSIDERED AS PART OF THE SPECIFICATIONS FOR THIS BUILDING, AND SHALL TAKE PREFERENCE OVER ANYTHING SHOWN, DESCRIBED OR IMPLIED WHERE SAME ARE AT VARIANCE.

MAPLE LEAF DESIGNS
4009 ARDSLEY CT.
GREENSBORO, NC 27407
PHONE 910 854 1556

GUY & TERI SMITH

DATE: 4/15/98

SHEET 2 OF 5

SECOND FLOOR PLAN

SCALE: 1/4"=1'-0"

MAPLE LEAF DESIGNS
4009 ARDSLEY CT.
GREENSBORO, NC 27407
PHONE 910 854 1556

GUY & TERI SMITH

DATE: 4/15/98

SHEET 2 OF