IREDELL COUNTY HEALTH DEPARTMENT

STATESVILLE 704-878-5305 MOORESVILLE 704-664-5281

IMPROVEMENT PERMIT / AUTHORIZATION TO CONSTRUCT / OPERATION PERMIT / EXISTING SYSTEM INSPECTION

PERMIT# 083260 PIN# 4636950201 DATE 8/4/2000

OWNER OR CONTRACTOR Chris Strom / Strom Construction PHONE: Business Pager 515-7789 Home 664-9267

ADDRESS 269 Elysian Dr. Mooresville, NC

LOCATION Brawley School Rd TL Cowpasture TL Broadbill 2nd on right

SUBDIVISION Woodland Hills BLOCK / SECTION 8 LOT 111 LOT AREA .8 Acre SITE CLASS. PS DESIGN FLOW 480gpd L.T.A.R. .3

Septic Tank: 1000 Gallons; STB 312 Date 10/2/00

Pump Tank: ____ Gallons; PT ____ Date ____

Pump Make: ____ Model ____ Serial No. ____

Nitrification Field: No. Fields 1 Square Feet 1620' Linear Feet 540'

No. Lines 6 at 90'ea Trench Width 36" Max Trench Bottom Depth 36" Gravel Depth 12"

☒ New System ☐ Repair System Type: I, II, III, IV, V, VI

System Description: Gravity - Conventional

Repair System Description Gravity/Pump Conventional

Maintenance Agreement Required: ☐ Yes ☐ No

☒ House/Mod. Home ☐ Mobile Home ☐ Business ☐ Other

No. Bedrooms 4 No. Bathrooms 2½ No. Employees ____


☐ Slab ☒ Crawl Space ☐ Basement w/plumbing ☐ Basement wo/plumbing

Water Supply: ☐ Individual ☒ Public ☒ Community


Comments:/Conditions: Keep Septic System at least 10' from PL, & 5' from house.

Comments:/Conditions: Replaces previously issued permits. LA Plan is what I used.

INITIAL SITE SKETCH Scale 1:50

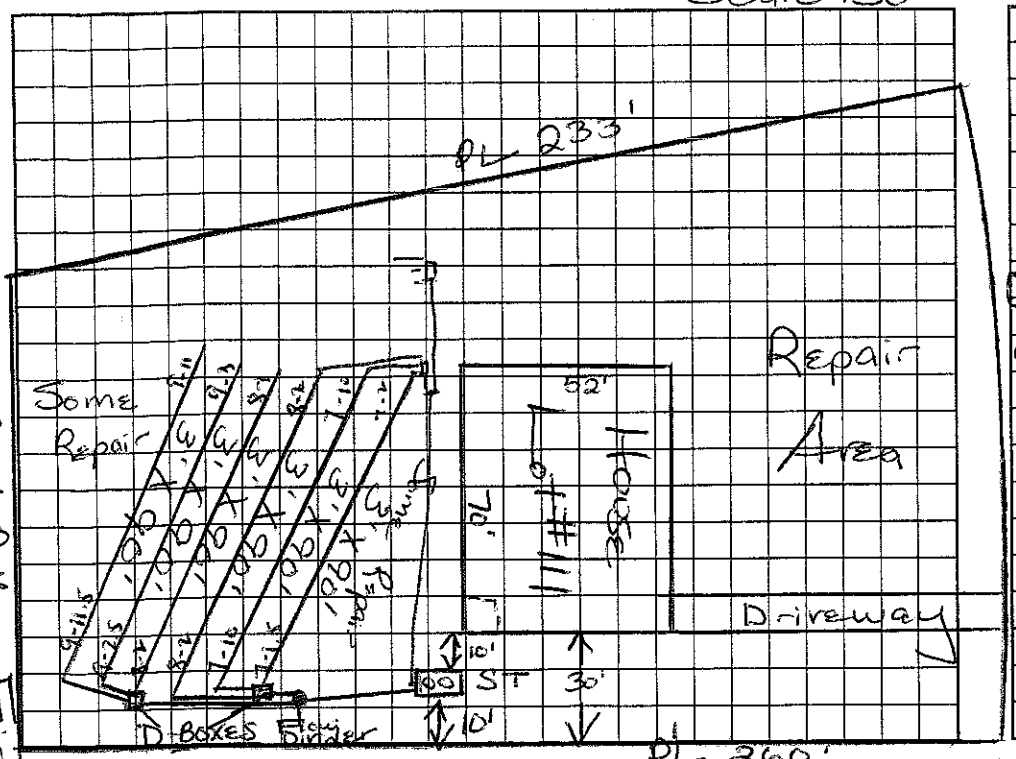

AS BUILT SKETCH

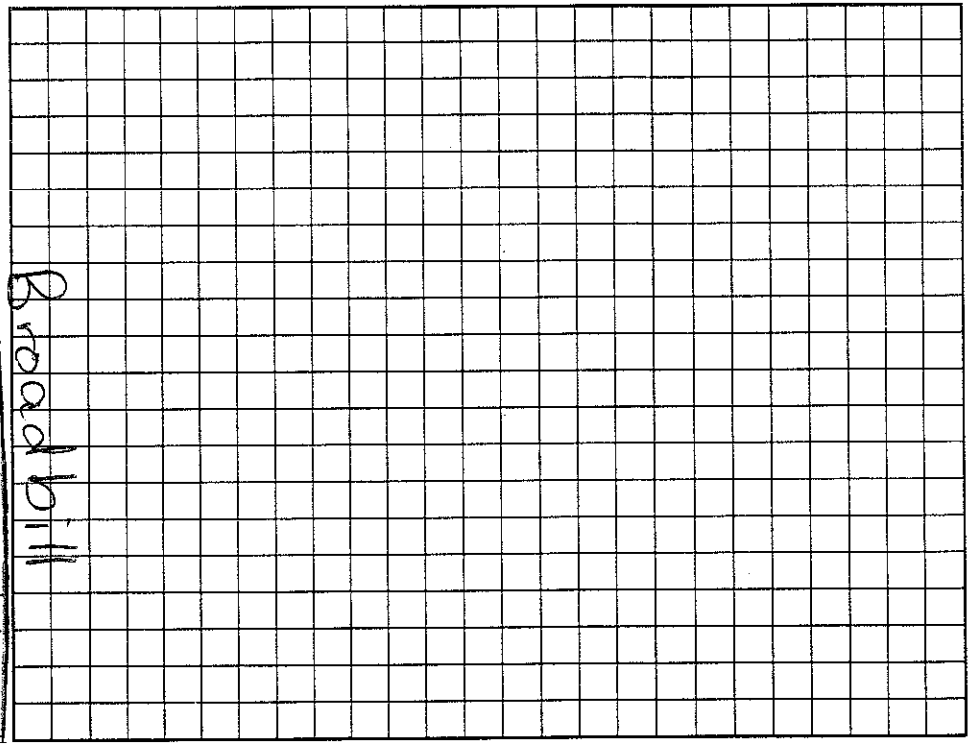

Permit can be suspended or revoked if any false information is supplied toward securing the permit/any unauthorized changes are made to the site/any unauthorized changes are made in the installation of the system. Improvement Permit with plat valid without expiration. Improvement Permit with site plan valid for sixty months. Authorization to Construct is valid for a period equal to that of Improvement Permit – not to exceed sixty months.

Signed: ____ date 8-10-00 Installed by: Orbison Const.

Improvement Permit by: Maria H.H. Dotson RS date 8/7/2000 Operation Permit by: Wesley Sparks RS. date 12/6/00

Authorization to Construct by: Maria H.H. Dotson RS date 8/7/2000 Existing System Inspection by: ____ date ____

HEALTH DEPT. COPY: WHITE OWNER COPY (FINAL): YELLOW OWNER COPY (INITIAL): PINK