IREDELL COUNTY HEALTH DEPARTMENT

STATESVILLE 704-878-5305 MOORESVILLE 704-664-5281

IMPROVEMENT PERMIT / AUTHORIZATION TO CONSTRUCT / OPERATION PERMIT / EXISTING SYSTEM INSPECTION

3rd

PERMIT# 072225 PIN# 4636 95 0540

OWNER OR CONTRACTOR Genesis Homes Inc.

ADDRESS PO Box 6219 Mooresville, NC 28115 PHONE: Business 664-9309 Home DATE 3/19/98

LOCATION TL Canvas Lock TR Broad Hill 1st lot on (L)

SUBDIVISION Woodland Hills BLOCK / SECTION 6 LOT 43 LOT AREA .5 Ac SITE CLASS PS DESIGN FLOW 360 L.T.A.R. .3

Septic Tank: 1000 Gallons; STB 794 Date 5/12/98

Pump Tank: ? Gallons; PT Date

Pump Make: Model Serial No.

Nitrification Field: No Fields 1 Square Feet 900 Linear Feet 300+

No Lines 3 Trench Width 36" Max Trench Bottom Depth 36"

[X] New System [ ] Repair System Type: I, II, [III] IV, V, VI

System Description: GRAVITY - Type III

Repair System Description: SAME

Maintenance Agreement Required: [ ] Yes [X] No

Gravel Depth SAND. [ ] Slab [X] Crawl Space [ ] Basement w/plumbing [ ] Basement wo/plumbing

[X] House/Mod. Home No. Bedrooms 3

[ ] Mobile Home No. Bathrooms 2.5

[ ] Business No. Employees


[ ] Other

Water Supply: [ ] Individual [ ] Public [X] Community

Comments:/Conditions: 7 - Tricky lot, plumbing must exit house at ground level - Pumping required if installed too deep.

Comments:/Conditions:

INITIAL SITE SKETCH

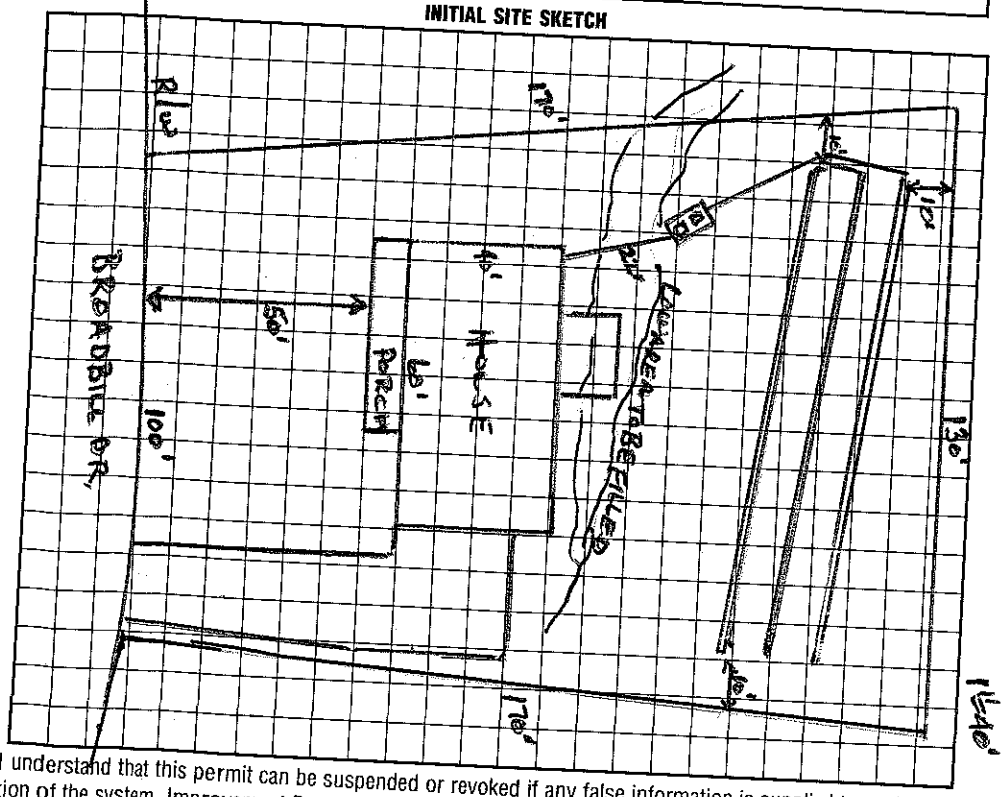

AS BUILT SKETCH

I understand that this permit can be suspended or revoked if any false information is supplied toward securing the permit/any unauthorized changes are made to the site/any unauthorized changes are made in the installation of the system. Improvement Permit with plat valid without expiration. Improvement Permit with site plan valid for sixty months. Authorization to Construct is valid for a period equal to that of Improvement Permit – not to exceed sixty months.

Signed: X Genesis Homes Inc. By Robert E. Jordan date 3/23/98

Improvement Permit by: Wesley Sparks RS. date 3/19/98

Authorization to Construct by: Wesley Sparks RS. date 3/19/98

Installed by: Curt Dunning

Operation Permit by: Wesley Sparks RS. date 7/24/98

Existing System Inspection by: Wesley Sparks RS. date 7/24/98

HEALTH DEPT. COPY: WHITE INSPECTION COPY (FINAL): GREEN OWNER COPY (FINAL): YELLOW INSPECTION COPY (INITIAL): PINK OWNER COPY (INITIAL): GOLD