IREDELL COUNTY HEALTH DEPARTMENT

STATESVILLE 704-878-5305 ∅ MOORESVILLE 704-664-5281 4.00

IMPROVEMENT PERMIT / AUTHORIZATION TO CONSTRUCT / OPERATION PERMIT / EXISTING SYSTEM INSPECTION

PERMIT# 112 061 PIN# ~~4636-95-5388-2~~ 4636950781 DATE 5/19/03

OWNER OR CONTRACTOR Tegland - Brown Const. PHONE: Business 704-895-9652 Home

ADDRESS 7502 Windalière Dr. Cornelius NC 28031

LOCATION Brawley Sch, TL Caldwell back, TL Macedonia, 2nd on Rt

SUBDIVISION Woodland Hills BLOCK / SECTION 10 LOT 2 LOT AREA 0.69AC SITE CLASS. PS DESIGN FLOW 450 L.T.A.R. 0.3

Septic Tank: 1000 Gallons; ST8 7961 Date 9-21-03
Pump Tank: Gallons; PT Date
Pump Make: Model Serial No.
Nitrification Field: No Fields 1 Square Feet 1600 Linear Feet 533
No Lines 5 Trench Width 36" Max Trench Bottom Depth 36" Gravel Depth 12"

☒ New System ☐ Repair System Type: I (II) III. IV. V. VI
System Description: Grav. Fy Conventional
Repair System Description: ~~25%~~ Reduction
Maintenance Agreement Required: ☐ Yes ☒ No Innovative

☒ House/Mod. Home No. Bedrooms 4
☐ Mobile Home No. Bathrooms 3
☐ Business No. Employees
☐ Other

☐ Slab ☒ Crawl Space ☐ Basement w/plumbing ☐ Basement wo/plumbing


Water Supply:
☐ Individual
☐ Public
☒ Community

Comments:/Conditions:

1" = 50'

Comments:/Conditions: Checked tanks & lines 11/27/03 MD

INITIAL SITE SKETCH

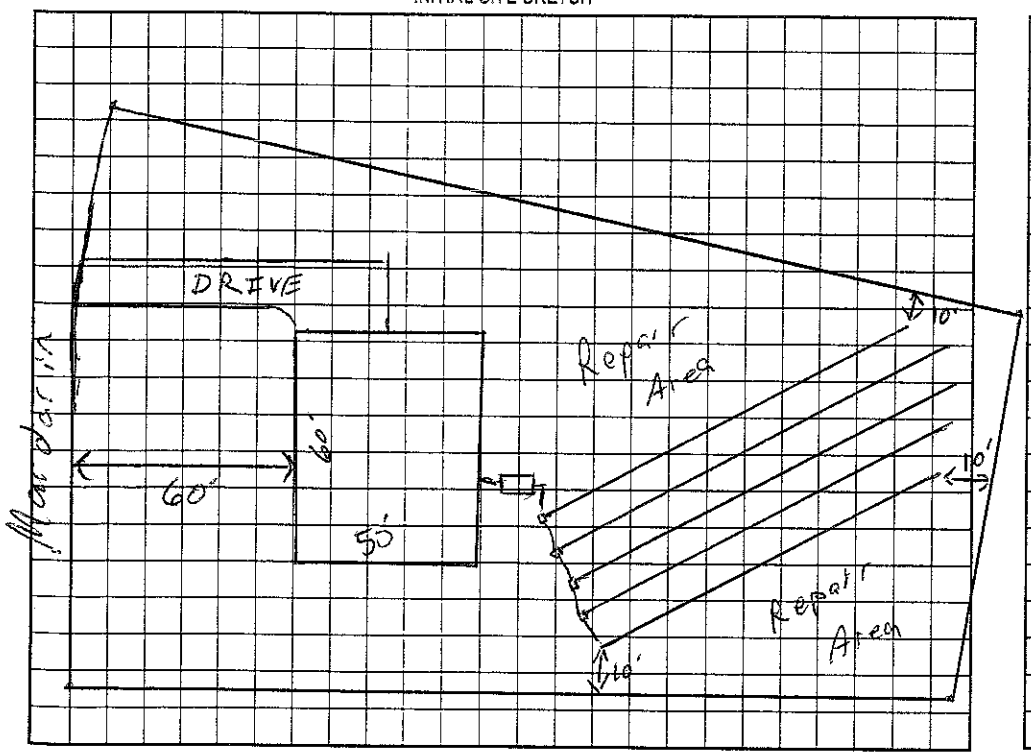

AS BUILT SKETCH

Permit can be suspended or revoked if any false information is supplied toward securing the permit/any unauthorized changes are made to the site/any unauthorized changes are made in the installation of the system. Improvement Permit with plat valid without expiration. Improvement Permit with site plan valid for sixty months. Authorization to Construct is valid for a period equal to that of Improvement Permit – not to exceed sixty months.

Signed: date 5/20/03 Installed by: Richard Abernathy

Improvement Permit by: RS date 5/19/03 Operation Permit by: Maria Watson RS date 2/3/04

Authorization to Construct by: RS date 5/19/03 Existing System Inspection by: date

HEALTH DEPT. COPY: WHITE OWNER COPY (FINAL): YELLOW OWNER COPY (INITIAL): PINK