IREDELL COUNTY HEALTH DEPARTMENT

STATESVILLE 704-878-5305 MOORESVILLE 704-664-5281

(3,130-000)

IMPROVEMENT PERMIT / AUTHORIZATION TO CONSTRUCT / OPERATION PERMIT / EXISTING SYSTEM INSPECTION

PERMIT# 071626 PIN# 4636951444

OWNER OR CONTRACTOR ~~BRUCE BLDG~~ / JERRY STOKWELL PHONE: Business Home DATE 04/28/98

ADDRESS 724 PONDERS END LN

LOCATION BRAWLEY SCHOOL RD - TL CANVASBACK - TL BRADDELL - 3RD ON LT

SUBDIVISION WOODLAND HILLS BLOCK / SECTION 6 LOT 44 LOT AREA .49 AC SITE CLASS PS DESIGN FLOW 360 L.T.A.R. .3

Septic Tank: 1000 Gallons; STB 2nd Date 3/16/98

Pump Tank: Gallons; PT Date

Pump Make: Model Serial No.

Nitrification Field: No Fields 1 Square Feet 900 Linear Feet 300

No Lines 7 Trench Width 36" Max Trench Bottom Depth 36" Gravel Depth N/A

☑ New System ☐ Repair System Type: I, II, III, IV, V, VI

System Description: GRAVITY CHAMBER 600 RHDS

Repair System Description: PUMP SAME

Maintenance Agreement Required: ☐ Yes ☑ No

☑ House/Mod. Home No. Bedrooms 3

☐ Mobile Home No. Bathrooms 2

☐ Business No. Employees

☐ Other

☐ Slab ☑ Crawl Space ☐ Basement w/plumbing ☐ Basement wo/plumbing


Water Supply: ☐ Individual ☐ Public ☑ Community

Comments:/Conditions:

Comments:/Conditions:

INITIAL SITE SKETCH

1"=50'

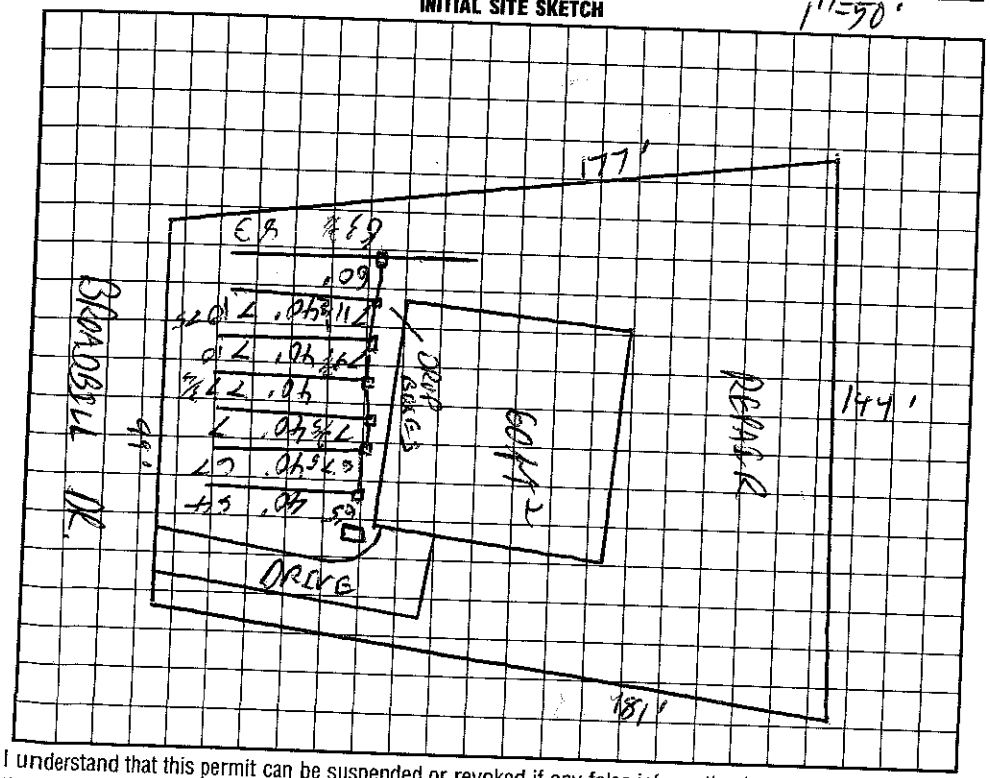

AS BUILT SKETCH

The proposed / existing POOL addition does not appear to impact the existing septic system.

**NOTE: REPAIR ESTABLISHED

C. [signature] R.S.

Date: 5/7/13

ICHD-Environmental Health Division

I understand that this permit can be suspended or revoked if any false information is supplied toward securing the permit/any unauthorized changes are made to the site/any unauthorized changes are made in the installation of the system. Improvement Permit with plat valid without expiration. Improvement Permit with site plan valid for sixty months. Authorization to Construct is valid for a period equal to that of Improvement Permit – not to exceed sixty months.

Signed: J Jerrell

Improvement Permit by: C. [signature] RS date 5/6/98

Authorization to Construct by: C [signature] RS date 4/28/98

Installed by: CURT DURNEO

Operation Permit by: C [signature] date 5/15/98

Existing System Inspection by: date

HEALTH DEPT. COPY: WHITE INSPECTION COPY (FINAL): GREEN OWNER COPY (FINAL): YELLOW INSPECTION COPY (INITIAL): PINK OWNER COPY (INITIAL): GOLD