4636952295

IREDELL COUNTY HEALTH DEPARTMENT

STATESVILLE 704-878-5305 MOORESVILLE 704-664-5281

IMPROVEMENT PERMIT / CERTIFICATE OF COMPLETION / OPERATION PERMIT / EXISTING SYSTEM INSPECTION

PROPERTY DESCRIPTION NO. 16656 DATE Feb. 3, '94 TAX MAP NO. 2619A46 Watershed: ☑ Yes ☐ No

OWNER OR CONTRACTOR Thomas B. McLaughlyn PHONE: Business _____ Home _____

ADDRESS Rt 11 Box 535, Mooresville LN

LOCATION Hoo Trail to Broadhill ~500' on left

SUBDIVISION Woodland Hills BLOCK / SECTION D LOT 46 LOT AREA ~20,000ft SITE CLASS. PS DESIGN FLOW 360 gpd L.T.A.R. .3

Septic Tank: 1000 Gallons; STB 714 Delmar Date 7-10-94

Pump Tank: _____ Gallons; PT _____ Date _____

Pump Make: _____ Model _____ Serial No. _____

Nitrification Field: No Fields 2 Square Feet 1200 Linear Feet 400

No Lines 10 Trench Width 36" Max Trench Bottom Depth 36" Gravel Depth 12"

☑ New System ☐ Repair System Type: I, II, III, IV, V, VI

System Description: gravity conv.

Repair System Description: gravity LPP PPBDS

Maintenance Agreement Required: ☐ Yes ☑ No

☑ House/Mod. Home No. Bedrooms 3

☐ Mobile Home No. Bathrooms 2½

☐ Business No. Employees _____

☐ Other _____


☐ Slab ☑ Crawl Space ☐ Basement w/plumbing ☐ Basement wo/plumbing

Water Supply: ☐ Individual ☑ Community ☐ Public


Comments: Exit plumbing at rear of house 21' downslope from right rear house corner and right/above existing grade. Place tank in position shown on sketch.

Comments:

INITIAL SITE SKETCH

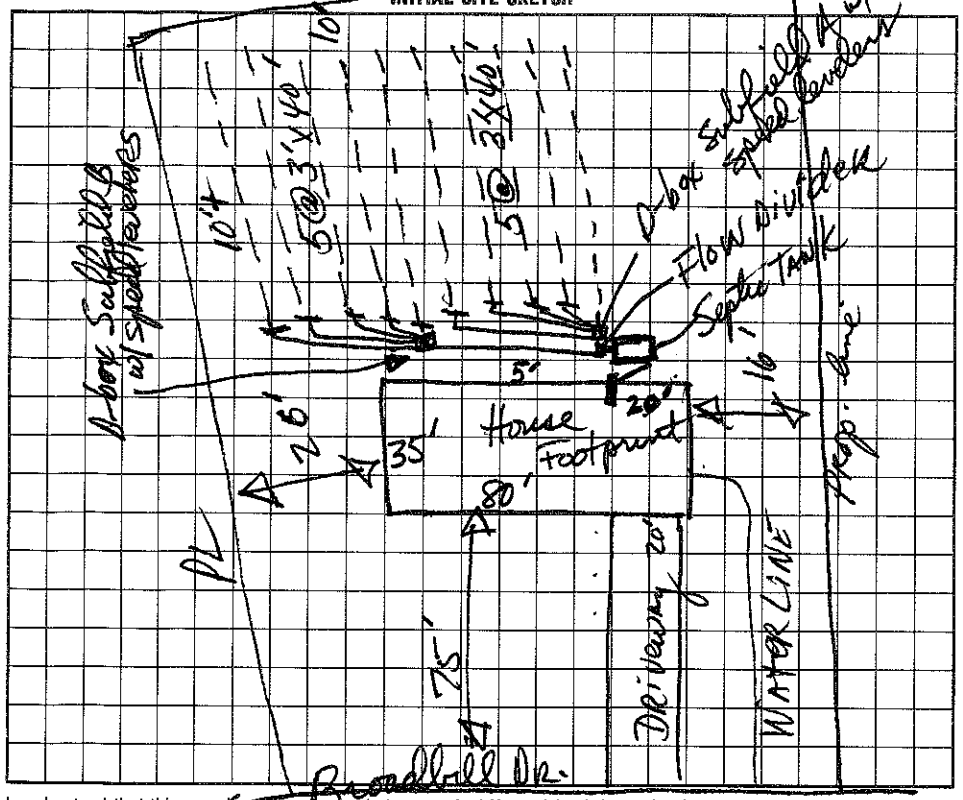

AS BUILT SKETCH

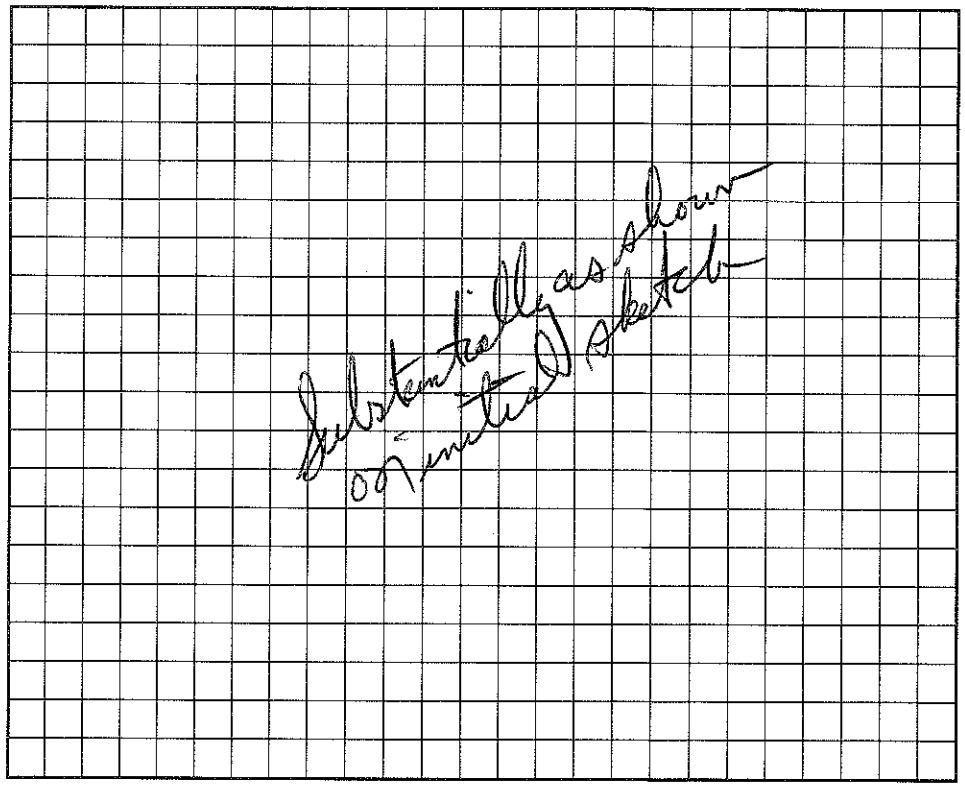

I understand that this permit can be suspended or revoked if any false information is supplied toward securing the permit/any unauthorized changes are made to the site/any unauthorized changes are made in the installation of the system. Improvement Permit is valid for 60 months from date of issuance.

Signed: _____

Improvement Permit by: _____, RS date 2-3-94

Existing System Inspection by: _____ date _____

Installed by: _____

Certificate of Completion by: _____, RS date 8/26/94

Operation Permit by: _____ date _____

HEALTH DEPT. COPY: WHITE INSPECTION COPY (FINAL): GREEN OWNER COPY (FINAL): YELLOW INSPECTION COPY (INITIAL): PINK OWNER COPY (INITIAL): GOLD