IREDELL COUNTY HEALTH DEPARTMENT

AUTHORIZATION TO CONSTRUCT

STATESVILLE 704-878-5305 MOORESVILLE 704-664-5281

IMPROVEMENT PERMIT / ~~CERTIFICATE OF COMPLETION~~ / OPERATION PERMIT / EXISTING SYSTEM INSPECTION

PROPERTY DESCRIPTION NO. 26365 DATE 8/25/97 TAX MAP NO. 4636952326 Watershed: ☑ Yes ☐ No

OWNER OR CONTRACTOR ALAN GOODNIGHT PHONE: Business _____ Home 663-3655

ADDRESS 522 RIVER HWY MOORESVILLE NC 28115

LOCATION BRAWLEY SCHOOL RD. TL CANVASBACK - TL BROADBILL - 4TH LOT ON LEFT

SUBDIVISION WOODLAND HILLS BLOCK / SECTION 6 LOT 45 LOT AREA - SITE CLASS. PS DESIGN FLOW 360GPD L.T.A.R. .36FD/FT²

Septic Tank: 1000 Gallons; STB 794 Date 5/12/98

Pump Tank: _____ Gallons; PT _____ Date _____

Pump Make: _____ Model _____ Serial No. _____

Nitrification Field: No Fields 1 Square Feet 900 Linear Feet 300

No Lines 8@37½' Trench Width 36" Max Trench Bottom Depth 36" Gravel Depth N/A

☑ New System ☐ Repair System Type: I, II, III, IV, V, VI

System Description: GRAVITY CHAMBERED OR HDS

Repair System Description: PUMP/GRAVITY PANEL

Maintenance Agreement Required: ☐ Yes ☑ No

☑ House/Mod. Home No. Bedrooms 3

☐ Mobile Home No. Bathrooms 2½

☐ Business No. Employees _____

☐ Other _____

☐ Slab ☑ Crawl Space ☐ Basement w/plumbing ☑ Basement wo/plumbing


Water Supply: ☐ Individual ☑ Community ☐ Public

Comments:


1"=30'

Comments: ⅓ PARTIAL

INITIAL SITE SKETCH

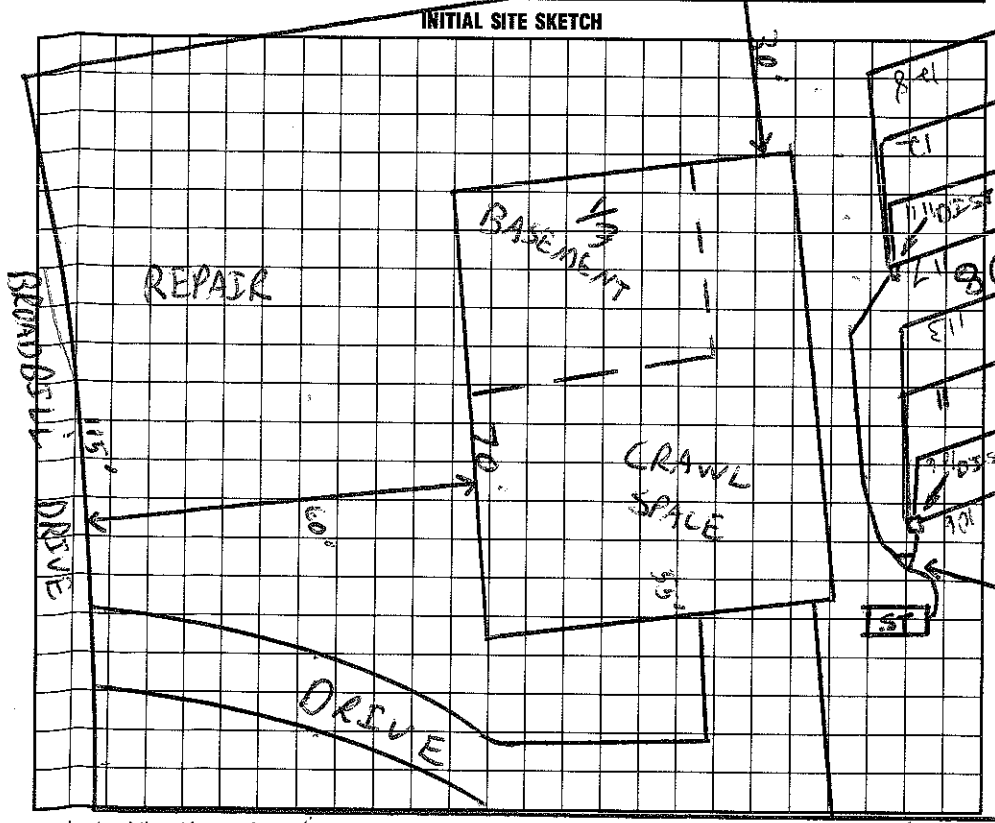

AS BUILT SKETCH

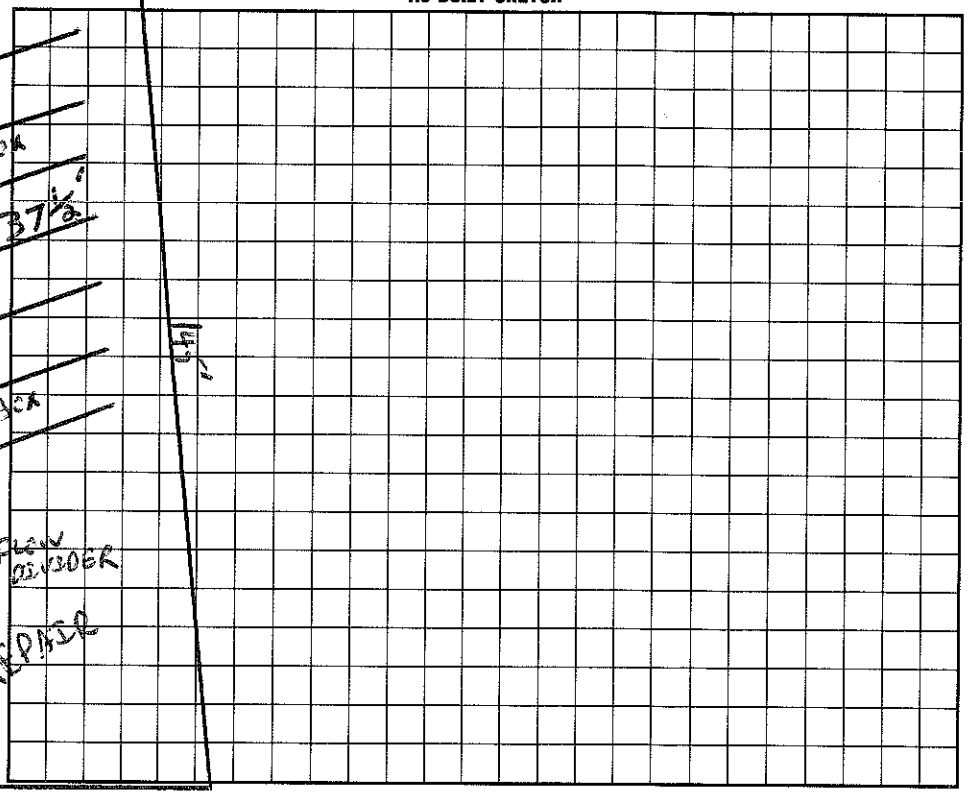

I understand that this permit can be suspended or revoked if any false information is supplied toward securing the permit/any unauthorized changes are made to the site/any unauthorized changes are made in the installation of the system. Improvement Permit is valid for 60 months from date of issuance.

Signed _____

Improvement Permit by: _____ date 8/25/97

AUTHORIZATION TO CONSTRUCT

~~Existing System Inspection by:~~ _____ date 9/15/97

Installed by: FD ERVIN

Certificate of Completion by: _____ date _____

Operation Permit by: _____ RS date 8/21/98

HEALTH DEPT. COPY: WHITE INSPECTION COPY (FINAL): GREEN OWNER COPY (FINAL): YELLOW INSPECTION COPY (INITIAL): PINK OWNER COPY (INITIAL): GOLD