IREDELL COUNTY HEALTH DEPARTMENT

Authorization to Construct

STATESVILLE 704-878-5305 MOORESVILLE 704-664-5281

4636953144

4pp

IMPROVEMENT PERMIT / ~~CERTIFICATE OF COMPLETION~~ / OPERATION PERMIT / EXISTING SYSTEM INSPECTION

PROPERTY DESCRIPTION NO. 23629 DATE 5/6/96 TAX MAP NO. 2G 19 A 47 Watershed: [X] Yes [ ] No

OWNER OR CONTRACTOR Robert Jones PHONE: Business Home 664-5195

ADDRESS 268 Spring Run Dr. Mooresville, NC. 28115

LOCATION Broadcliff - Brunsch TL Conoysbank TL Broadcliff ~ 3rd lot on (L)

Wellons Hills SUBDIVISION ~~Highland Hills~~ BLOCK / SECTION 6 LOT 47 LOT AREA .47 Ac SITE CLASS. PS DESIGN FLOW 360 L.T.A.R. .3

Septic Tank: 1000 Gallons; STB 749 Date 5/26/96
Pump Tank: Gallons; PT Date
Pump Make: Model Serial No.
Nitrification Field: No Fields 1 Square Feet 1200 Linear Feet ~~X~~ 300
No Lines 6 Trench Width 36" Max Trench Bottom Depth 36" Gravel Depth 6" SAND

[X] New System [ ] Repair System Type: I, II, [III], IV, V, VI
System Description: Cin P Septic - Flow Divider
Repair System Description: Same
Maintenance Agreement Required: [ ] Yes [ ] No

[X] House/Mod. Home No. Bedrooms 3
[ ] Mobile Home No. Bathrooms 2
[ ] Business No. Employees
[ ] Other


[ ] Slab [X] Crawl Space [ ] Basement w/plumbing [ ] Basement wo/plumbing

Water Supply:
[ ] Individual
[X] Community
[ ] Public


Comments: FLOW DIVIDER W/ 2 DIST BOXES

Comments:

INITIAL SITE SKETCH

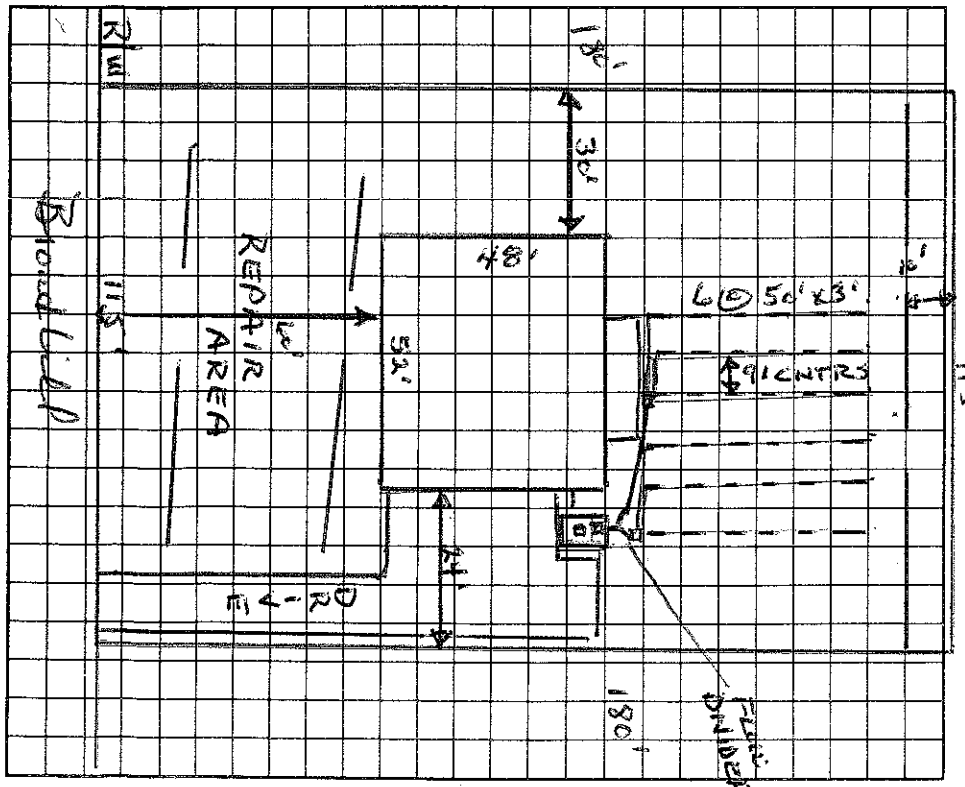

AS BUILT SKETCH

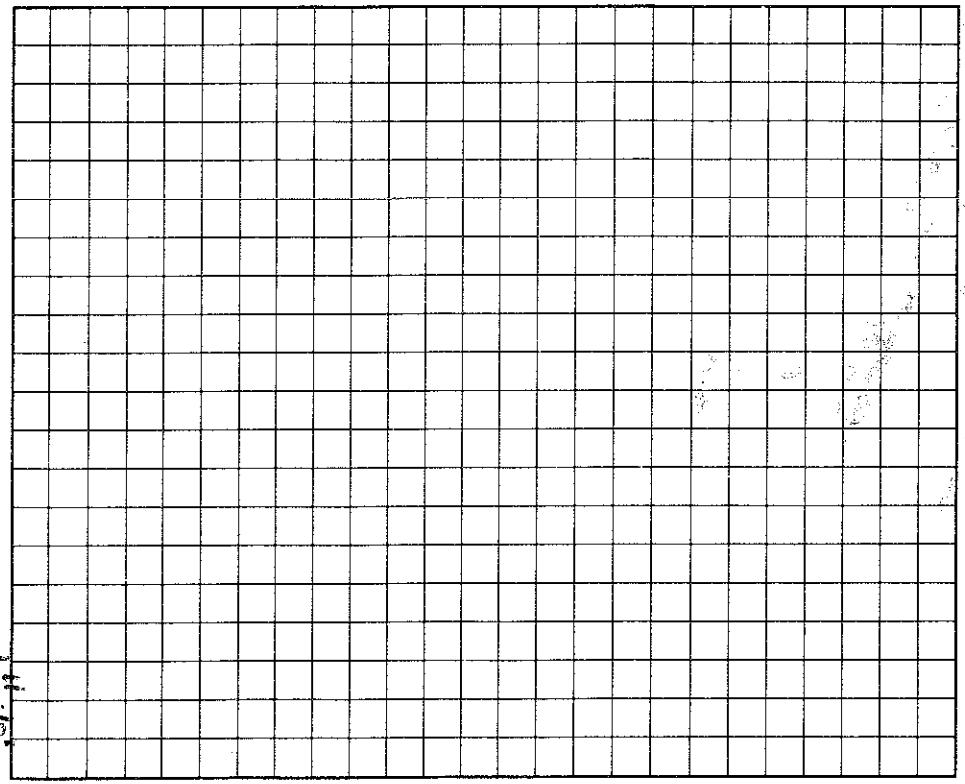

I understand that this permit can be suspended or revoked if any false information is supplied toward securing the permit/any unauthorized changes are made to the site/any unauthorized changes are made in the installation of the system.

Signed: Laura C Jones agent

Improvement Permit by: Wesley Sparks RS. date 5/6/96

Existing System Inspection by: ~~Contractor~~ Wesley Sparks RS. date 5/6/96

Installed by: Tim Simmons

Certificate of Completion by: date

Operation Permit by: Wesley Sparks RS. date 11/19/96

HEALTH DEPT. COPY: WHITE INSPECTION COPY (FINAL): GREEN OWNER COPY (FINAL): YELLOW INSPECTION COPY (INITIAL): PINK OWNER COPY (INITIAL): GOLD