IREDELL COUNTY HEALTH DEPARTMENT

STATESVILLE 704-878-5305 | MOORESVILLE 704-664-5281

130.00 Paid

IMPROVEMENT PERMIT / AUTHORIZATION TO CONSTRUCT / OPERATION PERMIT / EXISTING SYSTEM INSPECTION

PERMIT# 112069 PIN# 4636-95-5388-4 4636953507 DATE 12/10/03

OWNER OR CONTRACTOR Tegland - Brown Coast Inc PHONE: Business 704-895-9652 Home

ADDRESS 7502 Windgate Ct Cornelius NC 28105

LOCATION BSR, TL Canvasback, TL Mandarin on Rt 4th

SUBDIVISION Woodland Hills BLOCK / SECTION 10 LOT 4 LOT AREA 0.69 AC SITE CLASS. PS DESIGN FLOW 430 L.T.A.R. 0.3

Septic Tank: 1000 Gallons; STB 794 Date 12/20/03

Pump Tank: Gallons; PT Date

Pump Make: Model Serial No.

Nitrification Field: No Fields 1 Square Feet 1200 Linear Feet 400

No Lines 5 Trench Width 36" Max Trench Bottom Depth 36" Gravel Depth —

☒ New System ☐ Repair System Type: I, II, (III), IV, V, VI

System Description: Gravity 25% Red.

Repair System Description: LPP Panel Block

Maintenance Agreement Required: ☐ Yes ☒ No

☒ House/Mod. Home ☐ Mobile Home ☐ Business ☐ Other

No. Bedrooms 4 No. Bathrooms 3 No. Employees

Water Supply: ☐ Individual ☐ Public ☒ Community


☐ Slab ☒ Crawl Space ☐ Basement w/plumbing ☐ Basement wo/plumbing

Comments:/Conditions:


1" = 40'

Comments:/Conditions:

INITIAL SITE SKETCH

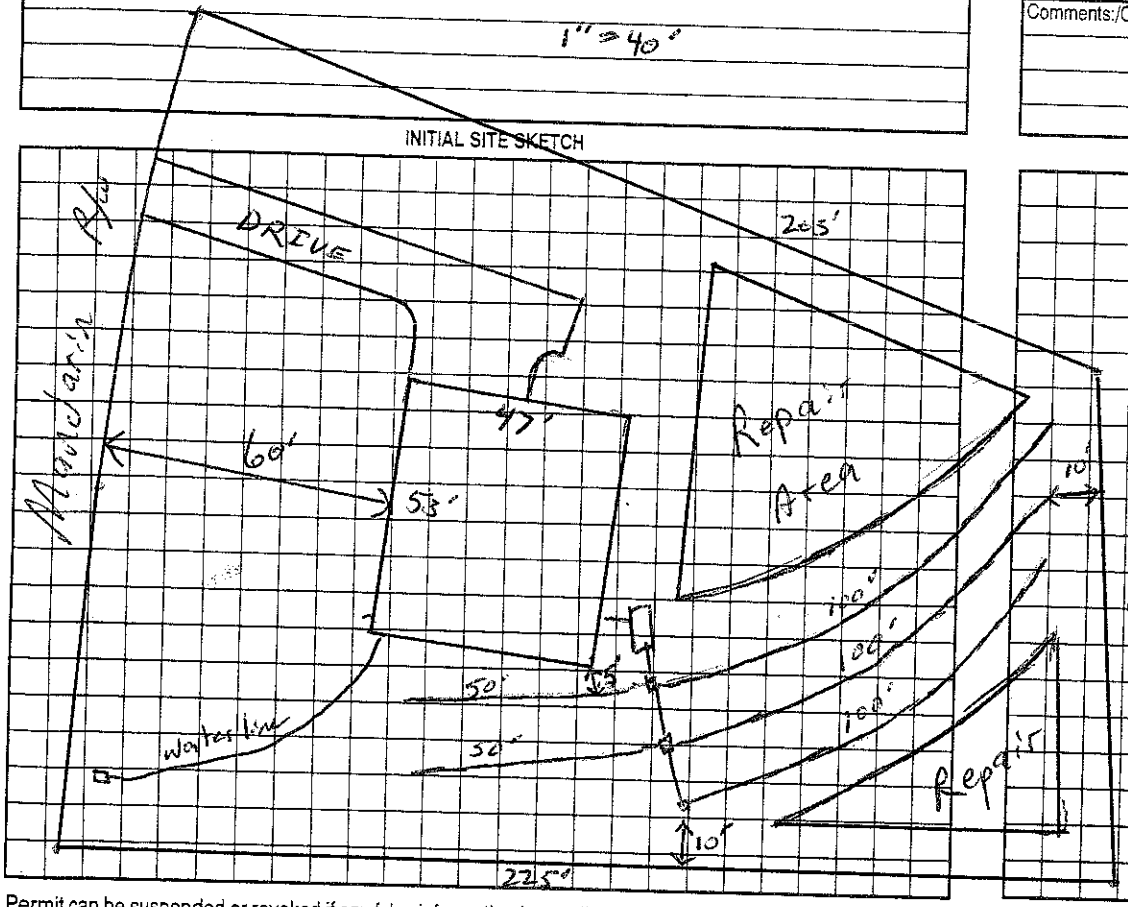

AS BUILT SKETCH

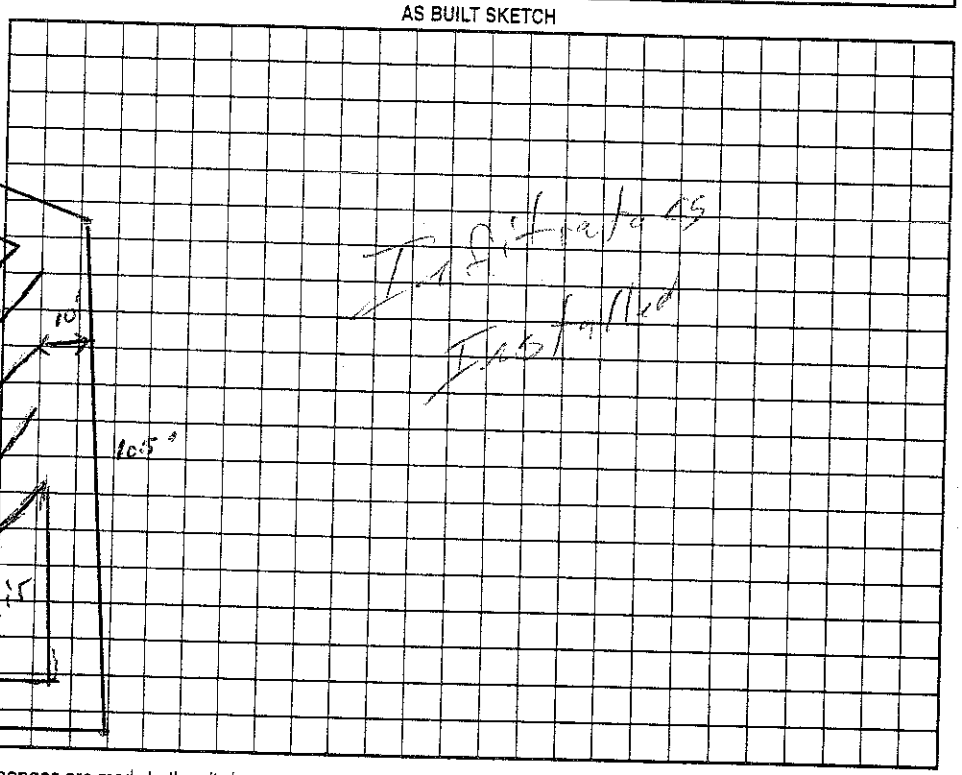

Permit can be suspended or revoked if any false information is supplied toward securing the permit/any unauthorized changes are made to the site/any unauthorized changes are made in the installation of the system. Improvement Permit with plat valid without expiration. Improvement Permit with site plan valid for sixty months. Authorization to Construct is valid for a period equal to that of Improvement Permit – not to exceed sixty months.

Signed: date 12-17-03 Installed by: Abernathy

Improvement Permit by: RS date 12/10/03 Operation Permit by: date 4/20/04

Authorization to Construct by: RS date 12/10/03 Existing System Inspection by: date

HEALTH DEPT. COPY: WHITE OWNER COPY (FINAL): YELLOW OWNER COPY (INITIAL): PINK