IREDELL COUNTY HEALTH DEPARTMENT

IMPROVEMENT PERMIT / AUTHORIZATION TO CONSTRUCT / OPERATION PERMIT / EXISTING SYSTEM INSPECTION

STATESVILLE 704-878-5305 130 MOORESVILLE 704-664-5281

PERMIT# 119303 PIN# 4636-95-4956.027 4636954798 DATE 3/30/04

OWNER OR CONTRACTOR Heritage Homes of the Carolinas Inc. PHONE: Business 704-663-2710 Home

ADDRESS PO Box 3373 Mooresville NC 28117

LOCATION BSR TL Cawkersback, TL Mandarin, 5th on Lt.

SUBDIVISION Woodland Hills BLOCK / SECTION 10 LOT 27 LOT AREA 0.72 Ac SITE CLASS. P5 DESIGN FLOW 480 L.T.A.R. 0.25

Septic Tank: 1000 Gallons; STB 350 Date 11/15/04

Pump Tank: Gallons; PT Date

Pump Make: Model Serial No.

Nitrification Field: No. Fields 1 Square Feet 1440 Linear Feet 480

No. Lines 5 @ 96' Trench Width 36" Max Trench Bottom Depth 36"

☒ New System ☐ Repair System Type: I, II, III, IV, V, VI

System Description: Gravity 25% Reduc.

Repair System Description: Parcel Block

Maintenance Agreement Required: ☐ Yes ☒ No

Gravel Depth —

☒ House/Mod. Home No. Bedrooms 4

☐ Mobile Home No. Bathrooms 3

☐ Business No. Employees

☐ Other

☐ Slab ☒ Crawl Space ☐ Basement w/plumbing ☐ Basement wo/plumbing


Water Supply: ☐ Individual ☐ Public ☒ Community

Comments:/Conditions:


1" = 50'

Comments:/Conditions:

INITIAL SITE SKETCH

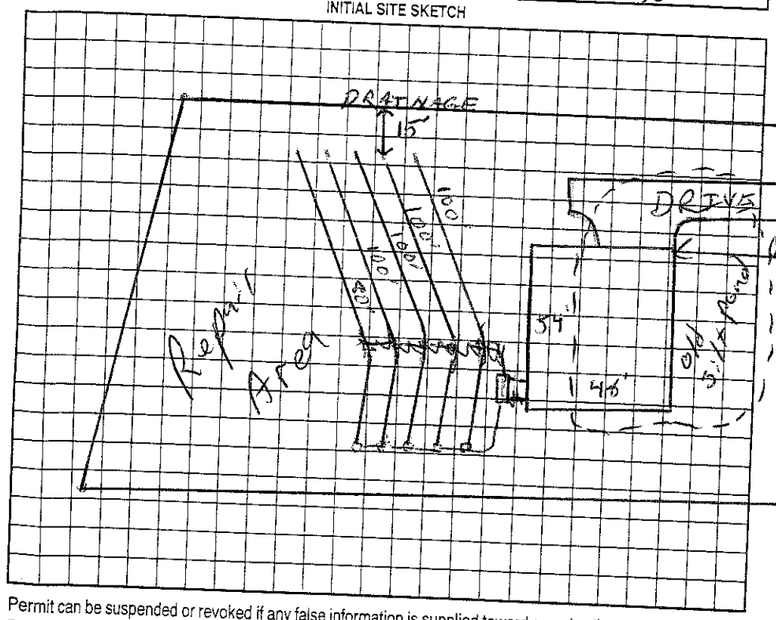

AS BUILT SKETCH

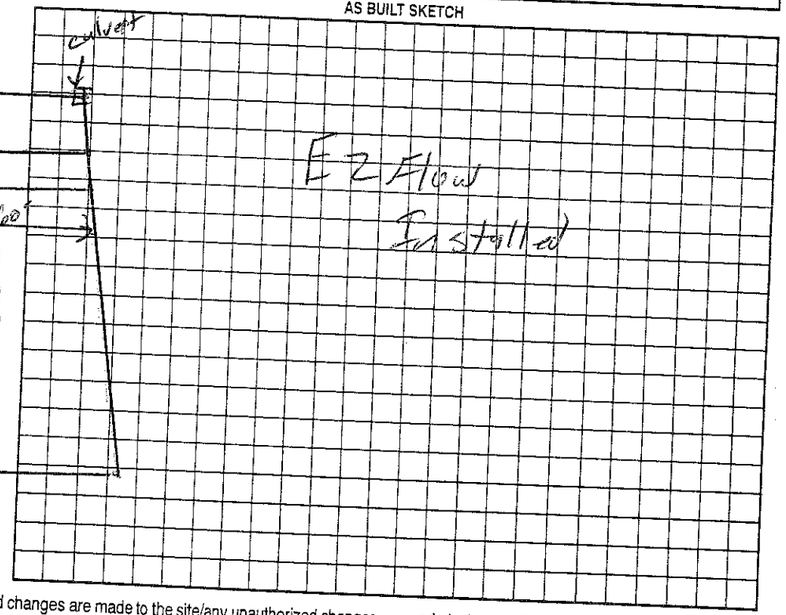

Permit can be suspended or revoked if any false information is supplied toward securing the permit/any unauthorized changes are made to the site/any unauthorized changes are made in the installation of the system. Improvement Permit with plat valid without expiration. Improvement Permit with site plan valid for sixty months. Authorization to Construct is valid for a period equal to that of Improvement Permit -- not to exceed sixty months.

Signed: WM Falk date 4-27-04

Improvement Permit by: RS date 3/30/04

Authorization to Construct by: RS date 3/30/04

Installed by: Piedmont Septic

Operation Permit by: RS date 11/27/05

Existing System Inspection by: date

HEALTH DEPT. COPY: WHITE OWNER COPY (FINAL): YELLOW OWNER COPY (INITIAL): PINK