IREDELL COUNTY HEALTH DEPARTMENT

IMPROVEMENT PERMIT / AUTHORIZATION TO C

...SVILLE 704-878-5305 MOORESVILLE 704-664-5281

...RUCT / OPERATION PERMIT / EXISTING SYSTEM INSPECTION

PERMIT# 114167 PIN# 4636 95 3355 4636955083 DATE 5/18/05

OWNER OR CONTRACTOR Tegland-Brown Const. PHONE: Business 704 361 1644 Home

ADDRESS 19550 Weavers Cir

LOCATION BS&A TL Canvasback + TL Mandarin + 8th on Rt SITE CLASS PS DESIGN FLOW 480 L.T.A.R. 0.3

SUBDIVISION Woodland Hills BLOCK / SECTION 10 LOT 7 LOT AREA 0.69ac

Septic Tank: 1000 Gallons: STB 312 Date 4/19/05

Pump Tank: Gallons: PT Date

Pump Make: Model Serial No.

Nitrification Field: No Fields 1 Square Feet 1200 Linear Feet 400

No Lines 5 Trench Width 36" Max Trench Bottom Depth 36"

Comments:/Conditions:

☒ New System ☐ Repair System Type: I, II, III, IV, V, VI

System Description: Gravity 25% Red

Repair System Description: Pump 25% Reduct

Maintenance Agreement Required: ☐ Yes ☐ No

Gravel Depth

☒ House/Mod. Home ☐ Mobile Home ☐ Business ☐ Other


No. Bedrooms 4 No. Bathrooms No. Employees

☐ Slab ☐ Crawl Space ☐ Basement w/plumbing ☐ Basement wo/plumbing


Water Supply: ☐ Individual ☐ Public ☒ Community

Comments:/Conditions:

INITIAL SITE SKETCH

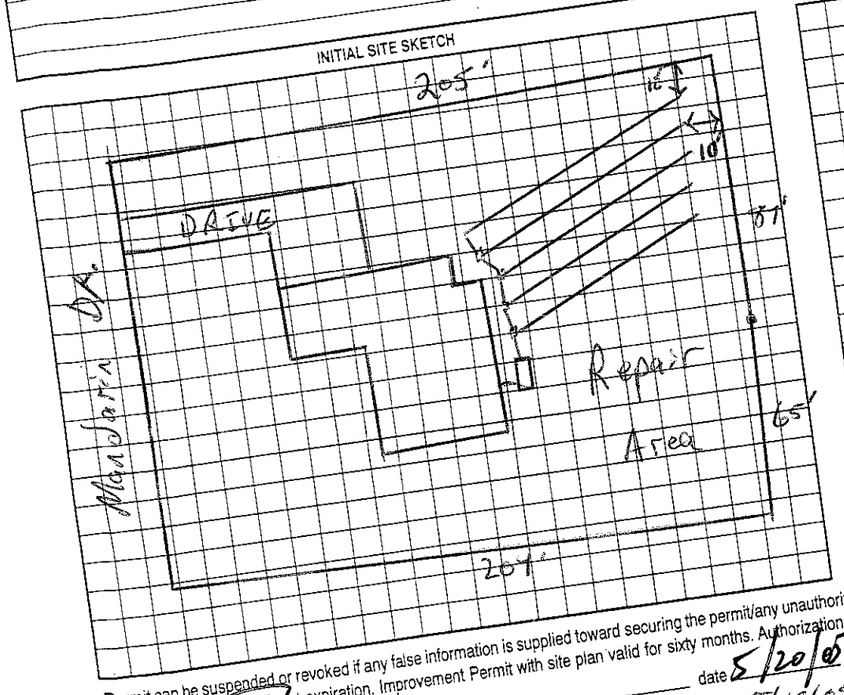

AS BUILT SKETCH

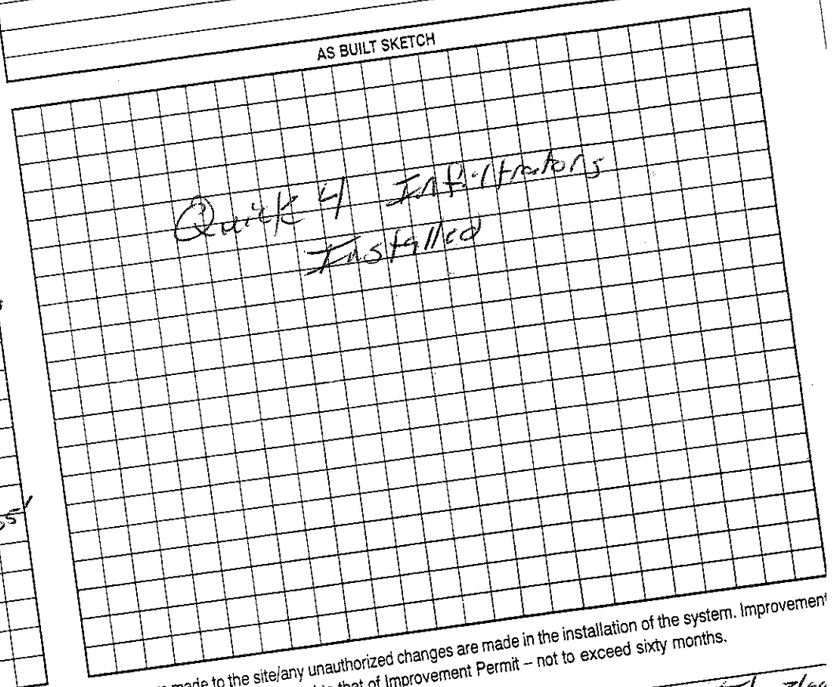

Permit can be suspended or revoked if any false information is supplied toward securing the permit/any unauthorized changes are made to the site/any unauthorized changes are made in the installation of the system. Improvement Permit with site plan valid for sixty months. Authorization to Construct is valid for a period equal to that of Improvement Permit – not to exceed sixty months.

Signed: Wm Brown date 5/20/05 Installed by: Abernathy date 5/23/05

...t Permit by: RS date 5/18/05 Operation Permit by: RS date

...n to Construct by: RS date 5/18/05 Existing System Inspection by: date

HEALTH DEPT. COPY: WHITE OWNER COPY (FINAL): YELLOW OWNER COPY (INITIAL): PINK