IREDELL COUNTY HEALTH DEPARTMENT

STATESVILLE 704-878-5305 130.00 Pd (3:30) MOORESVILLE 704-664-5281

IMPROVEMENT PERMIT / AUTHORIZATION TO CONSTRUCT / OPERATION PERMIT / EXISTING SYSTEM INSPECTION

PERMIT# 111511 PIN# ~~4636-95-8388~~ 4638955127.000 DATE 6/3/03

OWNER OR CONTRACTOR Nex Homes, LLC PHONE: Business 704-902-5684 Home

ADDRESS PO Box 4390 Mooresville NC 28117

LOCATION BSR, TL Canvas back, TL Mandarin, 7th on Rt.

SUBDIVISION Woodland Hills BLOCK / SECTION 10 LOT 7 LOT AREA 0.69Ac SITE CLASS. PS DESIGN FLOW 460 L.T.A.R. 0.5

Septic Tank: 1000 Gallons; STB 310 Date 11/17/03
Pump Tank: 1000 Gallons; PT 27 Date 11/17/03
Pump Make: Model Serial No.
Nitrification Field: No Fields 1 Square Feet 810 Linear Feet 270
No Lines 6@45' Trench Width 24" or 36" Max Trench Bottom Depth 36" Gravel Depth —

☒ New System ☐ Repair System Type: I, II, (III), IV, V, VI
System Description: Press. Man. Pond Block
Repair System Description: LP Pond Block
Maintenance Agreement Required: ☐ Yes ☒ No

☒ House/Mod. Home ☐ Mobile Home ☐ Business ☐ Other
No. Bedrooms 4 No. Bathrooms 3.5 No. Employees


☐ Slab ☒ Crawl Space ☐ Basement w/plumbing ☐ Basement wo/plumbing

Water Supply: ☐ Individual ☐ Public ☒ Community

Comments:/Conditions: 8Foc 9Foc
NO PRESSURE CHECKED

Comments:/Conditions:
Checked pressure 3/5/04

INITIAL SITE SKETCH

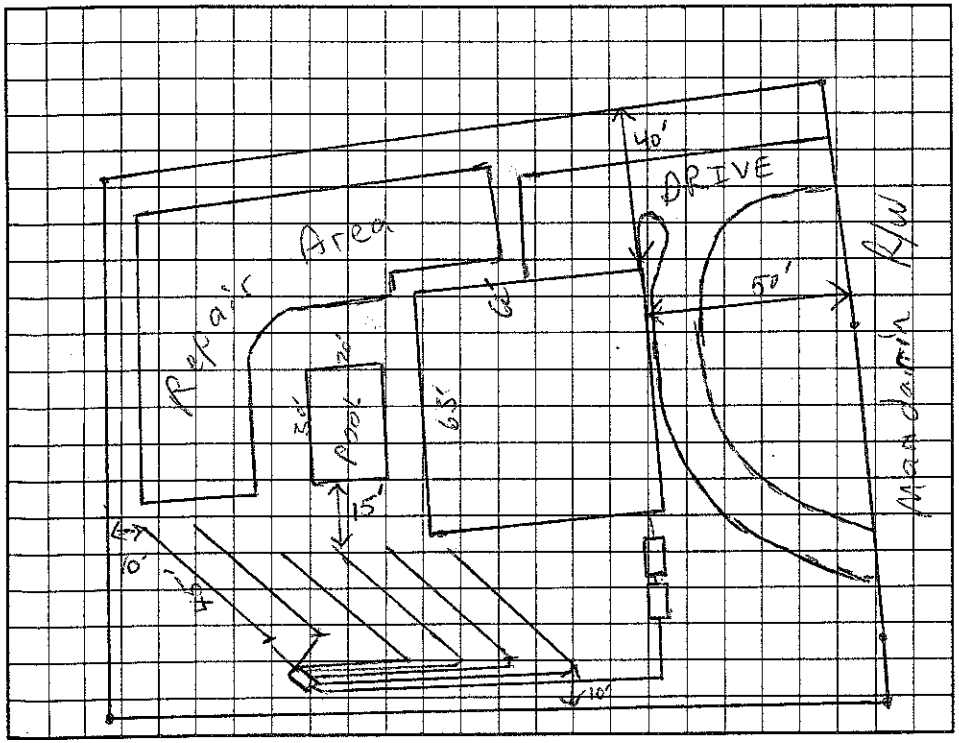

AS BUILT SKETCH

Permit can be suspended or revoked if any false information is supplied toward securing the permit/any unauthorized changes are made to the site/any unauthorized changes are made in the installation of the system. Improvement Permit with plat valid without expiration. Improvement Permit with site plan valid for sixty months. Authorization to Construct is valid for a period equal to that of Improvement Permit – not to exceed sixty months.

Signed: date 6-17-03

Improvement Permit by: RS date 6/3/03

Authorization to Construct by: RS date 6/3/03

Installed by: RICHARD ABERNATHY RS

Operation Permit by: Mana Jackson RS date 3/8/04

Existing System Inspection by: date

HEALTH DEPT. COPY: WHITE OWNER COPY (FINAL): YELLOW OWNER COPY (INITIAL): PINK