IREDELL COUNTY HEALTH DEPARTMENT

IMPROVEMENT PERMIT / AUTHORIZATION TO CONSTRUCT / OPERATION PERMIT / EXISTING SYSTEM INSPECTION

STATESVILLE 704-873-5305 130.00 Paid MOORESVILLE 704-664-5281

PERMIT# 112 113

OWNER OR CONTRACTOR Integra Builders Inc Kevin Kidd PHONE: Business 4036955647 Home 704701-2291 DATE

ADDRESS 127 Cades Cove Ln Mooresville NC 28117

LOCATION BSR TL Canvas back TL Mandarin OL 4

SUBDIVISION Woodland Hills BLOCK / SECTION 10 LOT 12

PIN# 4636-95-5508.29

LOT AREA 0.694c SITE CLASS PS DESIGN FLOW 450 L.T.A.R. 0.5

Septic Tank: 1000 Gallons; STB 312 Date 3/23/04

Pump Tank: Gallons; PT Date

Pump Make: Model Serial No.

Nitrification Field: No Fields 1 Square Feet 1200 Linear Feet 400'

No Lines 5 @ 80' Trench Width 36" Max Trench Bottom Depth 36"

Gravel Depth

☒ New System ☐ Repair System Type: I, II, III, IV, V

System Description: Gravity 25% Reduction

Repair System Description: LP Pedestal Block

Maintenance Agreement Required: ☐ Yes ☒ No

☐ Slab ☒ Crawl Space ☐ Basement w/plumbing ☐ Basement wo/plumbing

☒ House/Mod. Home No. Bedrooms 4

☐ Mobile Home No. Bathrooms 3½

☐ Business No. Employees

☐ Other


Water Supply: ☐ Individual ☐ Public ☒ Community

Comments/Conditions:


Drive will Move to opposite side

Comments/Conditions:

INITIAL SITE SKETCH

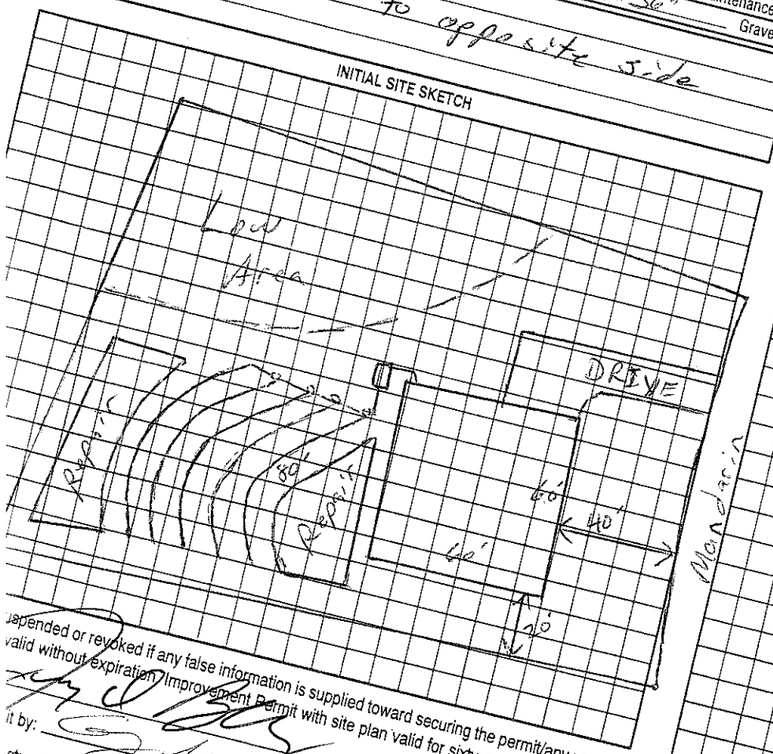

AS BUILT SKETCH

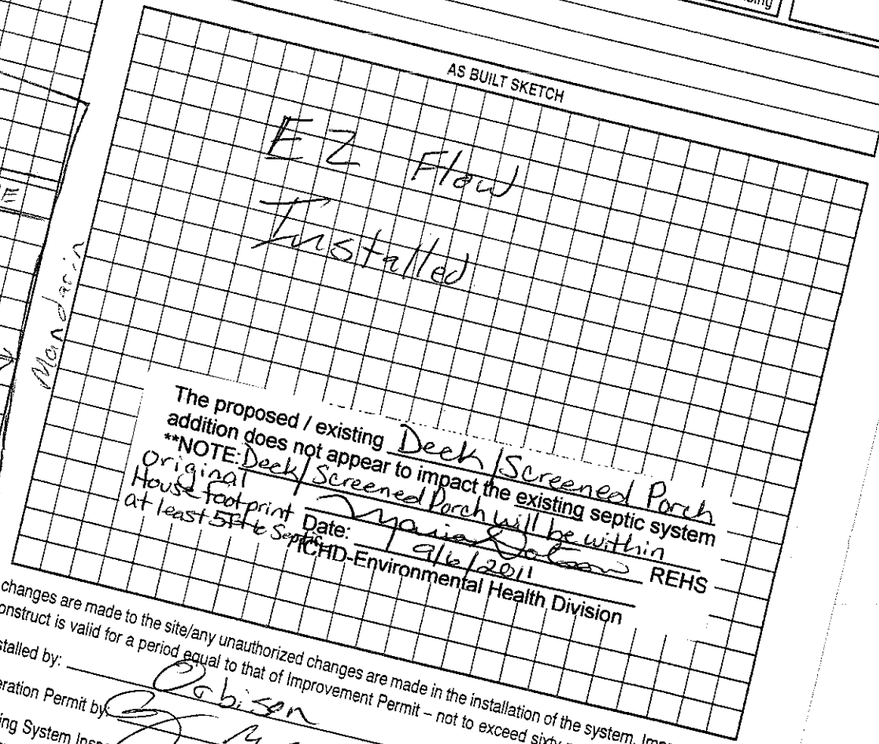

The proposed / existing Deck/Screened Porch addition does not appear to impact the existing septic system

**NOTE: Deck/Screened Porch will be within original House foot print at least 5ft to Septic

Date: 9/6/2011 REHS

ICHD-Environmental Health Division

Suspended or revoked if any false information is supplied toward securing the permit/any unauthorized changes are made to the site/any unauthorized changes are made in the installation of the system. Improvement Permit valid without expiration. Improvement Permit with site plan valid for sixty months. Authorization to Construct is valid for a period equal to that of Improvement Permit – not to exceed sixty months.

Permit by: RS date 6-11-03

Construct by: RS date 6/8/03

Installed by: Dobson date 12/9/03

Operation Permit by: RS date 5/12/04

Existing System Inspection by: date

HEALTH DEPT. COPY: WHITE OWNER COPY (FINAL): YELLOW OWNER COPY (INITIAL): PINK