IREDELL COUNTY HEALTH DEPARTMENT

STATESVILLE 704-878-5305 MOORESVILLE 704-664-5281

IMPROVEMENT PERMIT / AUTHORIZATION TO CONSTRUCT / OPERATION PERMIT / EXISTING SYSTEM INSPECTION

DATE 7/10/03

PERMIT# 113660 PIN# 4736-95-5308.18 4636956494

OWNER OR CONTRACTOR Margie Fuester MADELINE BLDRS. PHONE: Business 704-597-5502 Home

ADDRESS 11601-A Reames Rd Charlotte NC 28269

LOCATION BSR, TL Cantrell back, TL Mandarin on Lt.

SUBDIVISION Woodland Hills BLOCK / SECTION 10 LOT 18 LOT AREA 0.69AC SITE CLASS. RS DESIGN FLOW 490 L.T.A.R. 0.3

Septic Tank: 1000 Gallons; STB 794 Date 11/9/04

Pump Tank: Gallons; PT Date

Pump Make: Model Serial No. 400 Acc

Nitrification Field: No Fields 1 Square Feet 1600 Linear Feet ~~533~~

No Lines ~~5~~ 4 @ 107' Trench Width 36" Max Trench Bottom Depth 36"

☒ New System ☐ Repair System Type: ~~I II III IV V~~ Conventional

System Description: Gravity

Repair System Description: 25% Reduction

Maintenance Agreement Required: ☐ Yes ☒ No

Gravel Depth 12" ☐ Slab ☒ Crawl Space ☐ Basement w/plumbing ☐ Basement wo/plumbing

☒ House/Mod. Home ☐ Mobile Home ☐ Business ☐ Other

No. Bedrooms 4 No. Bathrooms 4 No. Employees

Water Supply: ☐ Individual ☐ Public ☒ Community

Comments:/Conditions:

4 @ 100' x 3'


5/21/05 4 BDRM HOUSE PLAN REVIEWED. AWS

1" = 40'


Comments:/Conditions:

ACCEPTED SYSTEM - 25% Reduced Req Lateral

INITIAL SITE SKETCH

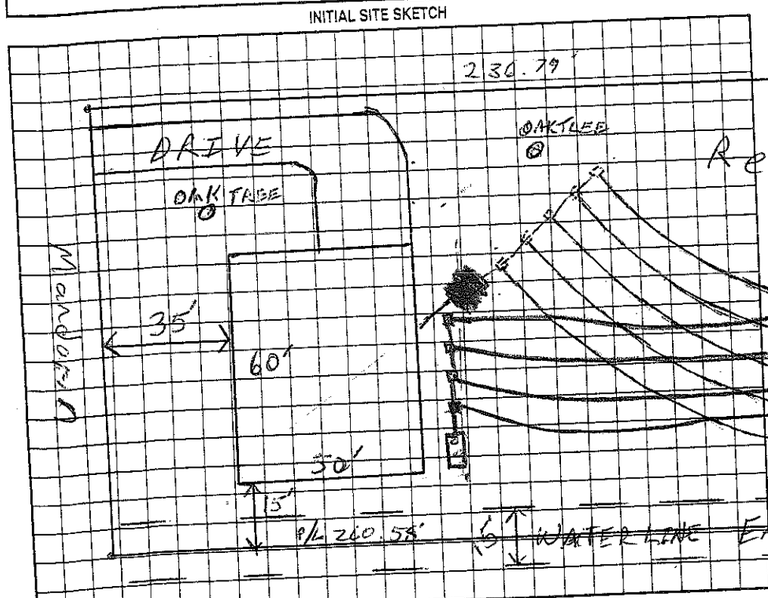

AS BUILT SKETCH

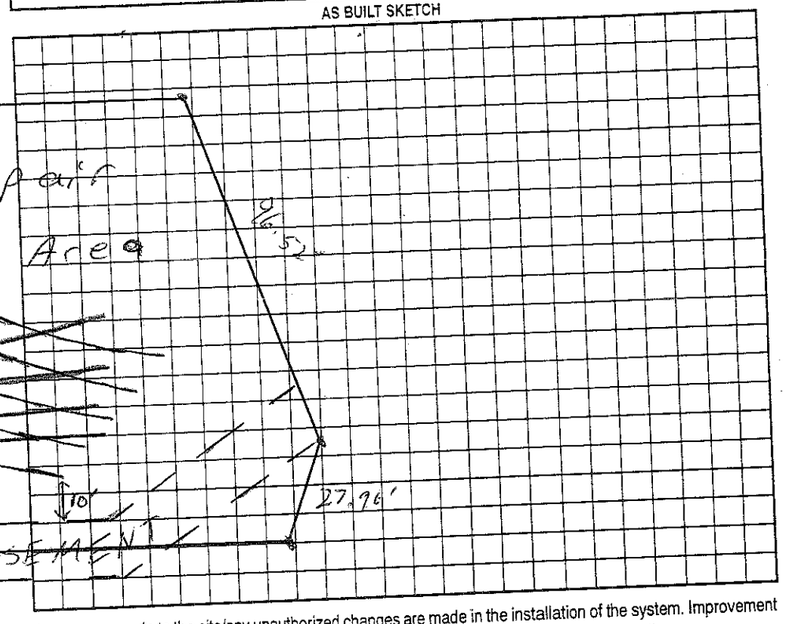

Permit can be suspended or revoked if any false information is supplied toward securing the permit/any unauthorized changes are made to the site/any unauthorized changes are made in the installation of the system. Improvement Permit with plat valid without expiration. Improvement Permit with site plan valid for sixty months. Authorization to Construct is valid for a period equal to that of Improvement Permit – not to exceed sixty months.

Signed: date 3-5-04

Improvement Permit by: RS date 7/11/03

Authorization to Construct by: W. Wesley Sparks RS. date 5/26/05

Installed by: Stanley Septic Tank

Operation Permit by: W. Wesley Sparks RS. date 3/8/06

Existing System Inspection by: date

HEALTH DEPT. COPY: WHITE OWNER COPY (FINAL): YELLOW OWNER COPY (INITIAL): PINK