IREDELL COUNTY HEALTH DEPARTMENT

STATESVILLE 704-378-5305 / 130.00 Paid MOORESVILLE 704-664-5281

IMPROVEMENT PERMIT / AUTHORIZATION TO CONSTRUCT / OPERATION PERMIT / EXISTING SYSTEM INSPECTION

PERMIT# 11512 PIN# 4636-45-5588-19

OWNER OR CONTRACTOR Nex Homes, LLC 4636956514 DATE 6/3/03

ADDRESS PO Box 4390 Mooresville NC 28117 PHONE: Business 704 902-5684 Home

LOCATION BSR TL Canvasback TL Mandarin on LT

SUBDIVISION Woodland Hills BLOCK / SECTION 10 LOT 19 LOT AREA 0.69ac SITE CLASS. PS DESIGN FLOW 480 L.T.A.R. 0.5

Septic Tank: 1000 Gallons; STB 794 Date 7/6/03

Pump Tank: Gallons; PT Date

Pump Make: Model Serial No.

Nitrification Field: No Fields 1 Square Feet 1200 Linear Feet 400

No Lines 4 Trench Width 36" Max Trench Bottom Depth 36" Gravel Depth

☒ New System ☐ Repair System Type: I, II, (III) IV, V, VI

System Description: Gravity 25% Reduction

Repair System Description: LP Panel Block

Maintenance Agreement Required: ☐ Yes ☒ No

☐ Slab ☒ Crawl Space ☐ Basement w/plumbing ☐ Basement wo/plumbing

☒ House/Mod. Home ☐ Mobile Home ☐ Business ☐ Other


No. Bedrooms 4 No. Bathrooms 3½ No. Employees

Water Supply: ☐ Individual ☐ Public ☒ Community


Comments/Conditions:

Comments/Conditions:

INITIAL SITE SKETCH

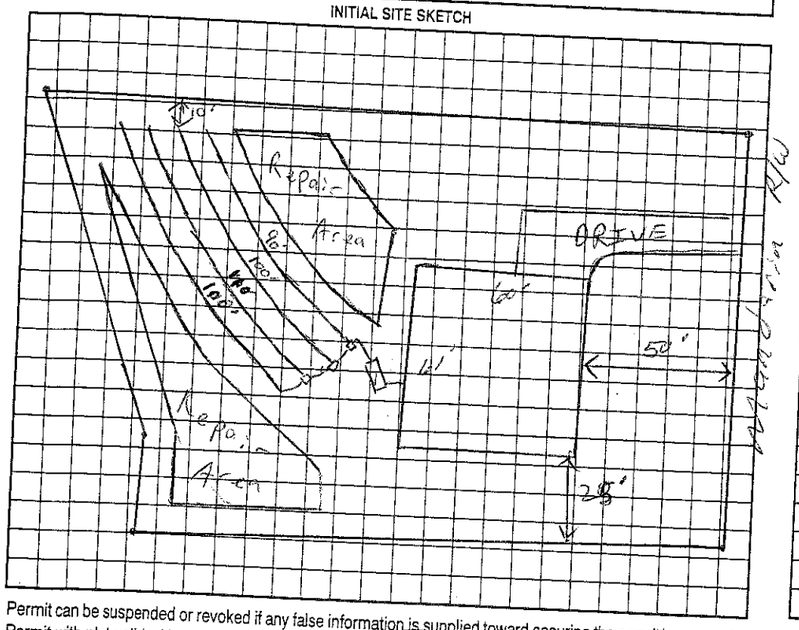

AS BUILT SKETCH

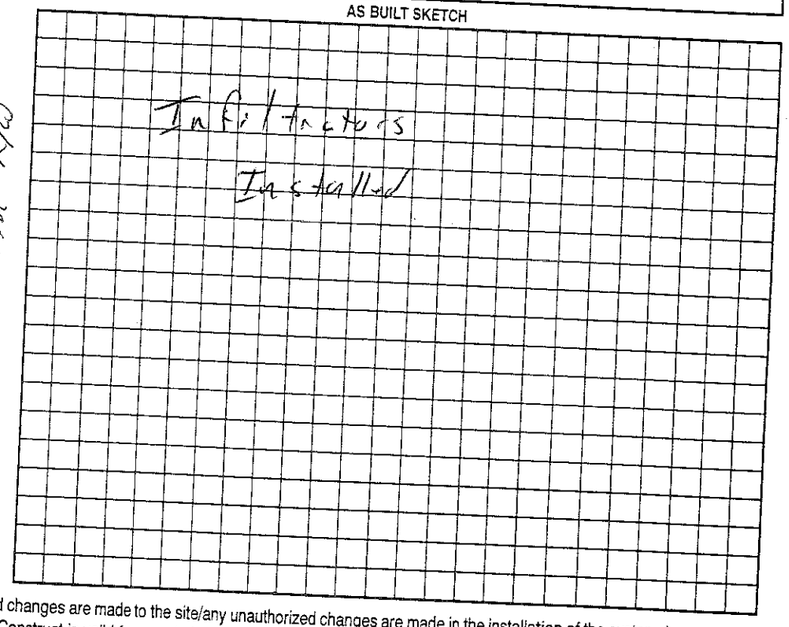

Permit can be suspended or revoked if any false information is supplied toward securing the permit/any unauthorized changes are made to the site/any unauthorized changes are made in the installation of the system. Improvement Permit with plat valid without expiration. Improvement Permit with site plan valid for sixty months. Authorization to Construct is valid for a period equal to that of Improvement Permit – not to exceed sixty months.

Signed: date 6-17-03

Improvement Permit by: RS date 6/3/03

Authorization to Construct by: RS date 6/5/03

Installed by: Abernathy

Operation Permit by: RS date 12/31/03

Existing System Inspection by: date

HEALTH DEPT. COPY: WHITE OWNER COPY (FINAL): YELLOW OWNER COPY (INITIAL): PINK