IREDELL COUNTY HEALTH DEPARTMENT

STATESVILLE 704-878-5305 MOORESVILLE 704-664-5281

IMPROVEMENT PERMIT / AUTHORIZATION TO CONSTRUCT / OPERATION PERMIT / EXISTING SYSTEM INSPECTION

PERMIT# 111782 PIN# 4636-95-5508.27 4636956878

OWNER OR CONTRACTOR Spear Const. PHONE: Business 704-636-7954 Home

ADDRESS 607 Anderson Ave. Salisbury NC 28144 DATE 11/13/03

LOCATION BSR + TL Canvasback, TL 2nd Woodduck LP, TR Crystal Ct, 1st on RT

SUBDIVISION Woodland Hills BLOCK / SECTION 10 LOT 23 LOT AREA 0.69Ac SITE CLASS. P3 DESIGN FLOW 360 L.T.A.R. 0.25

Septic Tank: 1000 Gallons; STB 625 Date 10/4/03

Pump Tank: Gallons; PT Date

Pump Make: Model Serial No.

Nitrification Field: No Fields 1 Square Feet 1080 Linear Feet 360

No Lines 6 Trench Width 36" Max Trench Bottom Depth 24"

☒ New System ☐ Repair System Type: I, II, (III), IV, V, VI

System Description: Gravity -5% Reduction

Repair System Description: LP Pond Block

Maintenance Agreement Required: ☐ Yes ☒ No

Gravel Depth —

☒ House/Mod. Home No. Bedrooms 3

☐ Mobile Home No. Bathrooms 2

☐ Business No. Employees

☐ Other


☐ Slab ☒ Crawl Space ☐ Basement w/plumbing ☐ Basement wo/plumbing

Water Supply: ☐ Individual ☐ Public ☒ Community


Comments:/Conditions:

Comments:/Conditions:

INITIAL SITE SKETCH

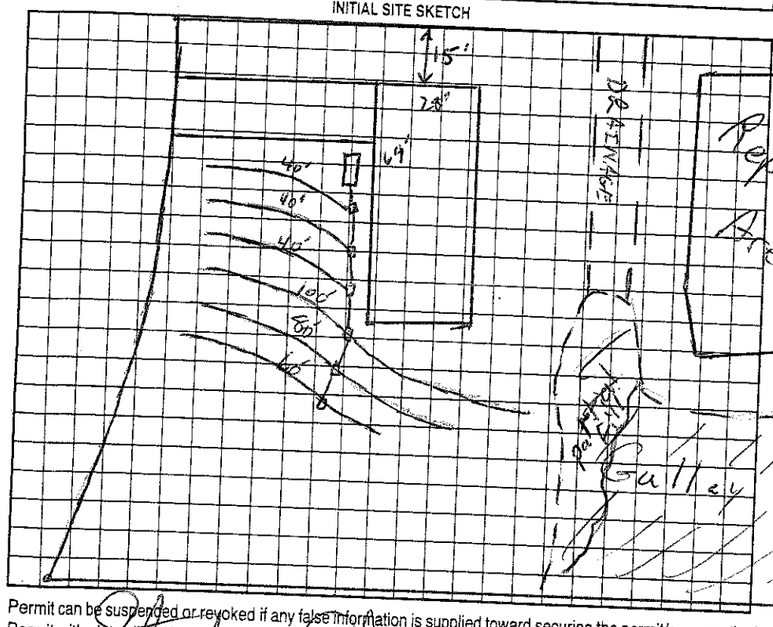

AS BUILT SKETCH

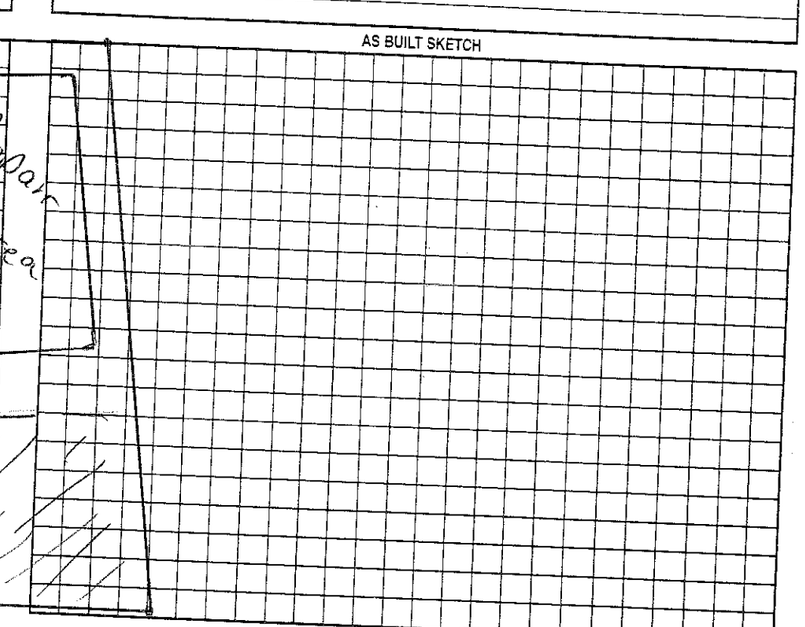

Permit can be suspended or revoked if any false information is supplied toward securing the permit/any unauthorized changes are made to the site/any unauthorized changes are made in the installation of the system. Improvement Permit with plat valid without expiration. Improvement Permit with site plan valid for sixty months. Authorization to Construct is valid for a period equal to that of Improvement Permit – not to exceed sixty months.

Signed: date 12-15-03

Improvement Permit by: RS date 11/13/03

Authorization to Construct by: RS date 11/15/03

Installed by: Rowan Septic

Operation Permit by: RS date 12/16/03

Existing System Inspection by: date

HEALTH DEPT. COPY: WHITE OWNER COPY (FINAL): YELLOW OWNER COPY (INITIAL): PINK