IREDELL COUNTY HEALTH DEPARTMENT

STATESVILLE 704-878-5305 MOORESVILLE 704-664-5281

#130

IMPROVEMENT PERMIT / AUTHORIZATION TO CONSTRUCT / OPERATION PERMIT / EXISTING SYSTEM INSPECTION

PERMIT# 112705 PIN# ~~4636 95 5388~~ 4636957280

OWNER OR CONTRACTOR S+L Homes

ADDRESS PO Box 4509 Mooresville, NC. 28117 PHONE: Business 704-202-9461 Home DATE 7/1/03

LOCATION 1100 TL Conversback TL Mandarin on (L) B4 cul de sac

SUBDIVISION WOODLAND HILLS BLOCK / SECTION 10 LOT 16 LOT AREA .69 Ac SITE CLASS PS DESIGN FLOW 480 L.T.A.R. .3

Septic Tank: 1000 Gallons; STB 794 Date 7/20/05

Pump Tank: Gallons; PT Date

Pump Make: Model Serial No.

Nitrification Field: No Fields 1 Square Feet 1200 ✱ Linear Feet 400 ✱

No Lines 3 @ 133 Trench Width 3 Max Trench Bottom Depth 3' Gravel Depth NA

[X] New System [ ] Repair System Type: I, II, (III), IV, V, VI

System Description: GRAVITY - Type 3

Repair System Description: 16" PPBPS

Maintenance Agreement Required: [ ] Yes [X] No

[X] House/Mod. Home No. Bedrooms 4

[ ] Mobile Home No. Bathrooms 3

[ ] Business No. Employees

[ ] Other

[ ] Slab [X] Crawl Space [ ] Basement w/plumbing [ ] Basement wo/plumbing


Water Supply: [ ] Individual [ ] Public [X] Community

Comments:/Conditions:

Comments:/Conditions:

(1" = 50')

INITIAL SITE SKETCH

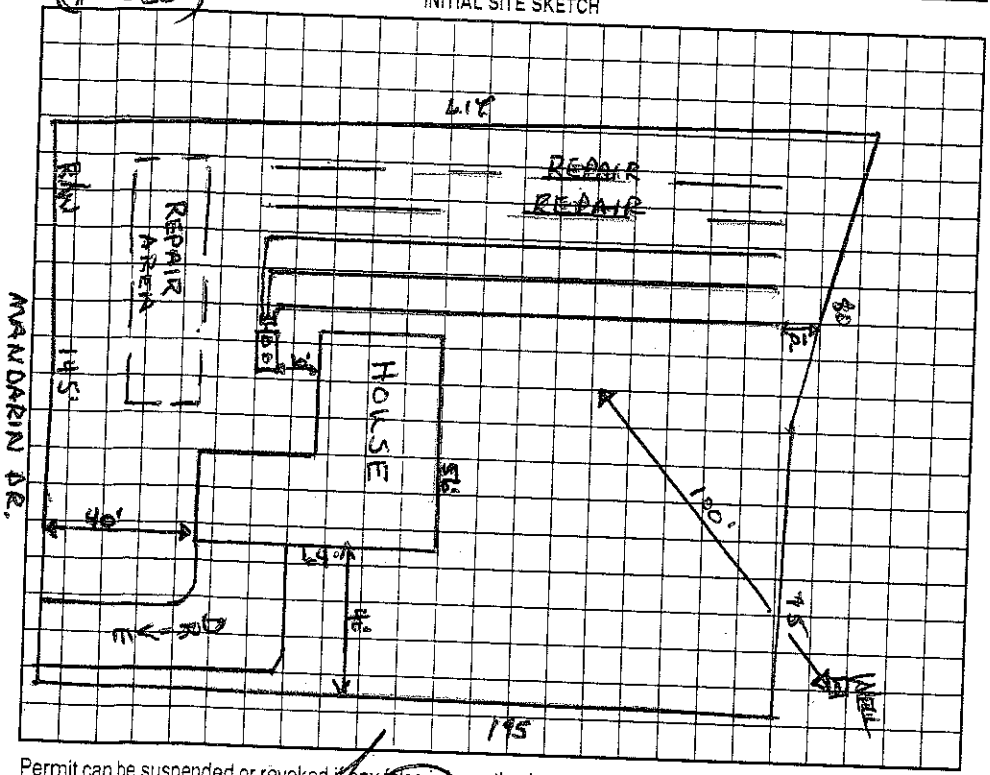

AS BUILT SKETCH

Permit can be suspended or revoked if any false information is supplied toward securing the permit/any unauthorized changes are made to the site/any unauthorized changes are made in the installation of the system. Improvement Permit with plat valid without expiration. Improvement Permit with site plan valid for sixty months. Authorization to Construct is valid for a period equal to that of Improvement Permit – not to exceed sixty months.

Signed: ✱ date 7/3/03

Improvement Permit by: Wesley Sparks RS. date 7/1/03

Authorization to Construct by: Wesley Sparks RS. date 7/1/03

Installed by: Richard Abernathy

Operation Permit by: RS date 12/9/05

Existing System Inspection by: date

HEALTH DEPT. COPY: WHITE OWNER COPY (FINAL): YELLOW OWNER COPY (INITIAL): PINK