IREDELL COUNTY HEALTH DEPARTMENT — STATESVILLE 704-878-5305 — MOORESVILLE 704-664-5281

IMPROVEMENT PERMIT / AUTHORIZATION TO CONSTRUCT / OPERATION PERMIT / EXISTING SYSTEM INSPECTION

PERMIT# 112114 PIN# 4636-95-5388.17 4636957333 DATE 3/15/04

OWNER OR CONTRACTOR Integra Builders PHONE: Business 704-779-6399 Home

ADDRESS 127 Eades Cove Ln Mooresville NC 28117

LOCATION BSR, TL Canvasback, TL Mandarin, on Lt

SUBDIVISION Woodland Hills BLOCK / SECTION 10 LOT 17 LOT AREA 30,005 Ft² SITE CLASS PS DESIGN FLOW 450 L.T.A.R. 0.3

Septic Tank: 1000 Gallons; STB Date 12/29/03

Pump Tank: Gallons; PT Date

Pump Make: Model Serial No.

Nitrification Field: No Fields 1 Square Feet 1605 Linear Feet 535

No Lines 5 @ 107' Trench Width 36" Max Trench Bottom Depth 36" Gravel Depth 12"

☒ New System ☐ Repair System Type: I, II, III, IV, V, VI

System Description: Gravity Conventional

Repair System Description: Pump Innovative

Maintenance Agreement Required: ☐ Yes ☒ No

☒ House/Mod. Home No. Bedrooms 4

☐ Mobile Home No. Bathrooms 3

☐ Business No. Employees

☐ Other

☐ Slab ☒ Crawl Space ☐ Basement w/plumbing ☐ Basement wo/plumbing


Water Supply: ☐ Individual ☐ Public ☒ Community

Comments:/Conditions:

1"=50'

Comments:/Conditions:

INITIAL SITE SKETCH

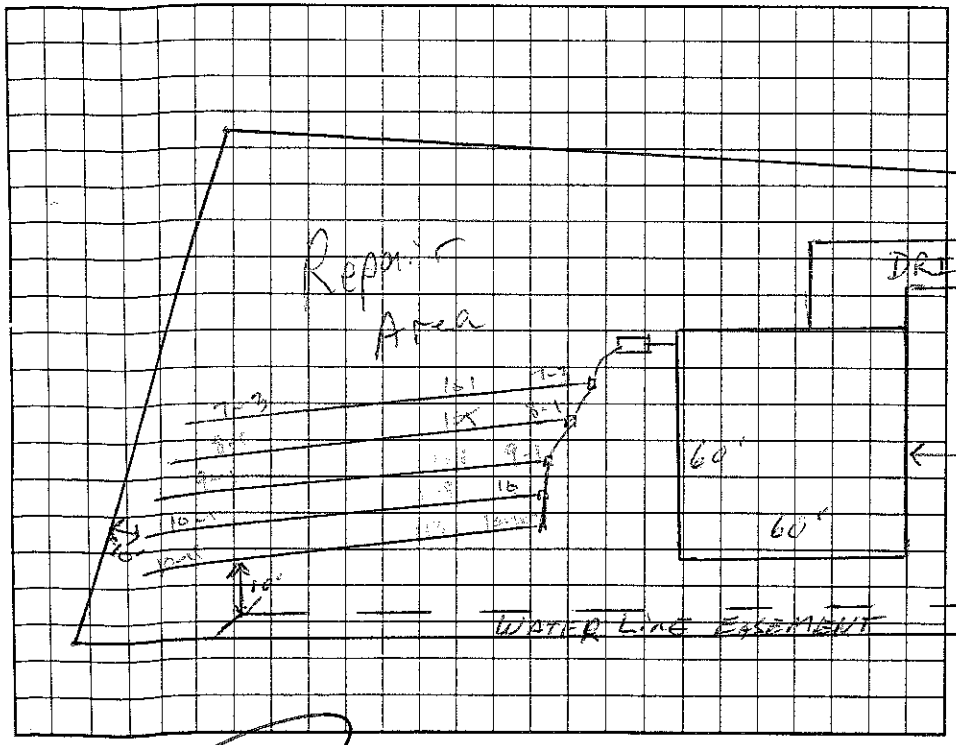

AS BUILT SKETCH

Permit can be suspended or revoked if any false information is supplied toward securing the permit/any unauthorized changes are made to the site/any unauthorized changes are made in the installation of the system. Improvement Permit with plat valid without expiration. Improvement Permit with site plan valid for sixty months. Authorization to Construct is valid for a period equal to that of Improvement Permit – not to exceed sixty months.

Signed: date

Permit by: RS date 3/15/04

to Construct by: RS date 3/15/04

Installed by: Dobson Const.

Operation Permit by: Wesley Sparks RS. date 5/11/04

Existing System Inspection by: date

HEALTH DEPT. COPY: WHITE OWNER COPY (FINAL): YELLOW OWNER COPY (INITIAL): PINK