IREDELL COUNTY HEALTH DEPARTMENT

AUTHORIZATION TO CONSTRUCT (10:30)

STATESVILLE 704-878-5305 MOORESVILLE 704-664-5281

IMPROVEMENT PERMIT / ~~CERTIFICATE OF COMPLETION~~ / OPERATION PERMIT / EXISTING SYSTEM INSPECTION

PROPERTY DESCRIPTION NO. 069773 DATE 10/29/97 TAX MAP NO. 4636959584 Watershed: ☑ Yes ☐ No

OWNER OR CONTRACTOR EDWIN ENGRAM PHONE: Business _____ Home 872-9773

ADDRESS 119 BUFFALO ST STATESVILLE NC 28677

LOCATION CANVASBACK - TL CRYSTAL BAY - ON RT CORNER OF MOONSTONE

SUBDIVISION CRYSTAL BAY BLOCK / SECTION _____ LOT 59 LOT AREA _____ SITE CLASS. PS DESIGN FLOW 360 GPD L.T.A.R. .3 GPD/FT²

Septic Tank: 1000 Gallons; STB 821 Date 1/21/98

Pump Tank: _____ Gallons; PT _____ Date _____

Pump Make: _____ Model _____ Serial No. _____

Nitrification Field: No Fields 1 Square Feet 900 Linear Feet 300

No Lines 3 @ 100' Trench Width 36" Max Trench Bottom Depth 36" Gravel Depth N/A

☑ New System ☐ Repair System Type: I, II, (III), IV, V, VI

System Description: GRAVITY CHAMBERED ORADS

Repair System Description: GRAVITY PANEL

Maintenance Agreement Required: ☐ Yes ☑ No

☑ House/Mod. Home No. Bedrooms 3

☐ Mobile Home No. Bathrooms 3

☐ Business No. Employees ____

☐ Other _____


☐ Slab ☑ Crawl Space ☐ Basement w/plumbing ☐ Basement wo/plumbing

Water Supply: ☑ Individual ☐ Community ☐ Public


Comments:

Comments:

INITIAL SITE SKETCH

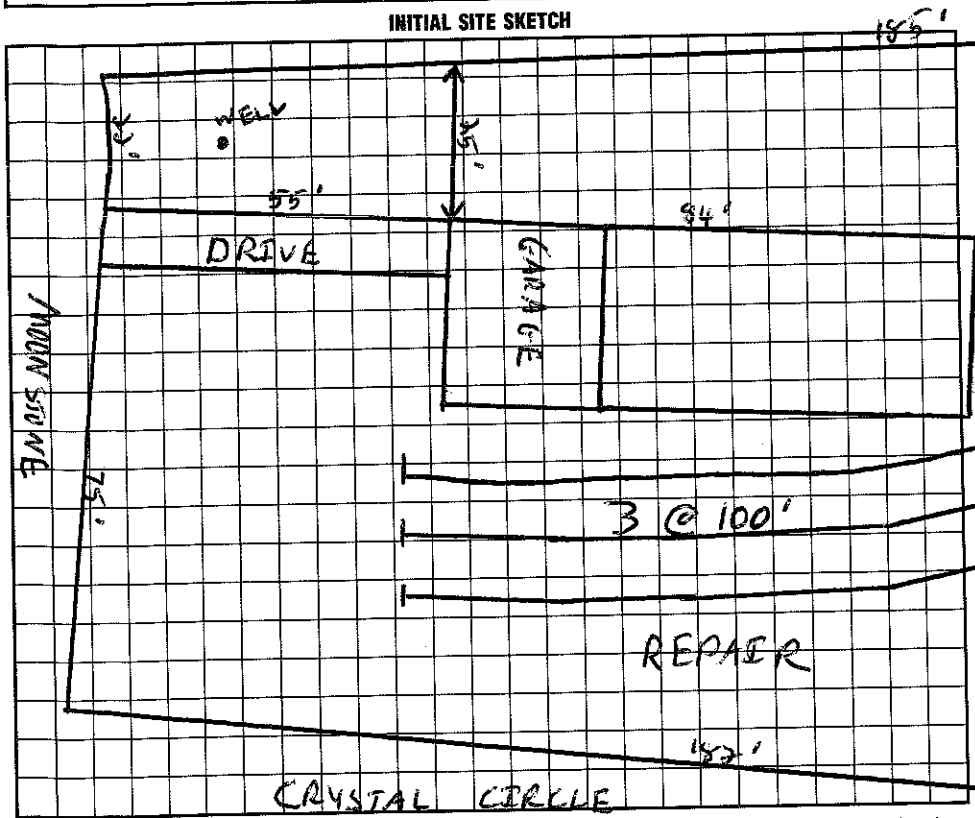

AS BUILT SKETCH

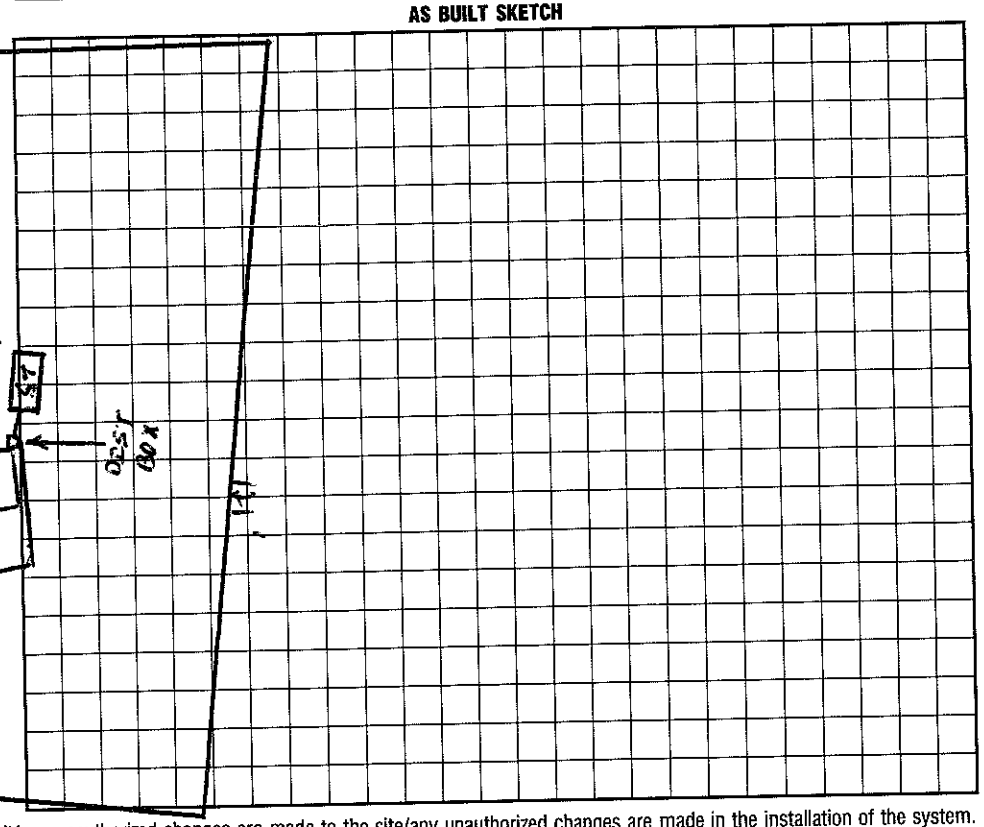

I understand that this permit can be suspended or revoked if any false information is supplied toward securing the permit/any unauthorized changes are made to the site/any unauthorized changes are made in the installation of the system.

Improvement Permit is valid for 60 months from date of issuance.

Signed: Edwin D. Engram

Improvement Permit by: C. Ruby Lear date 10/29/97

~~Authorization~~ Existing System Inspection by: C. Ruby Lear date 10/29/97

Installed by: Gary Miller

Certificate of Completion by: Wesley Sparks R.S. date 9/28/98

Operation Permit by: Wesley Sparks R.S. date 9/28/98

TO CONSTRUCT HEALTH DEPT. COPY: WHITE INSPECTION COPY (FINAL): GREEN OWNER COPY (FINAL): YELLOW INSPECTION COPY (INITIAL): PINK OWNER COPY (INITIAL): GOLD