IREDELL COUNTY HEALTH DEPARTMENT

STATESVILLE 704-878-5305 MOORESVILLE 704-664-5281

IMPROVEMENT PERMIT / AUTHORIZATION TO CONSTRUCT / OPERATION PERMIT / EXISTING SYSTEM INSPECTION

PERMIT# 104395 PIN# 4636 96 3378.1 DATE 2/1/02

OWNER OR CONTRACTOR Howard Neal PHONE: Business _____ Home 704-664-1735

ADDRESS 336 Wood Duck Loop. Mooresville, NC. 28117

LOCATION 1100 Ti Cemetery Rd (L) 332 Woodduck

SUBDIVISION No BLOCK / SECTION _____ LOT _____ LOT AREA .69 AC SITE CLASS. PS DESIGN FLOW 240 L.T.A.R. .3

Septic Tank: 1000 Gallons; STB 317 Date 9/30/02
Pump Tank: _____ Gallons; PT _____ Date _____
Pump Make: _____ Model _____ Serial No. _____
Nitrification Field: No Fields 1 Square Feet 800 Linear Feet 266
No Lines 3@88' Trench Width 3' Max Trench Bottom Depth 3' Gravel Depth 12"

☒ New System ☐ Repair System Type: I, (II), III, IV, V, VI
System Description: GRAV - CONVENTIONAL
Repair System Description: SAME
Maintenance Agreement Required: ☐ Yes ☐ No


☒ House/Mod. Home No. Bedrooms 2
☐ Mobile Home No. Bathrooms 1
☐ Business No. Employees _____
☐ Other _____
☐ Slab ☒ Crawl Space ☐ Basement w/plumbing ☐ Basement wo/plumbing

Water Supply:
☒ Individual
☐ Public
☐ Community
HOWARDS

Comments:/Conditions:

Comments:/Conditions:

(1" = 50') 143 INITIAL SITE SKETCH

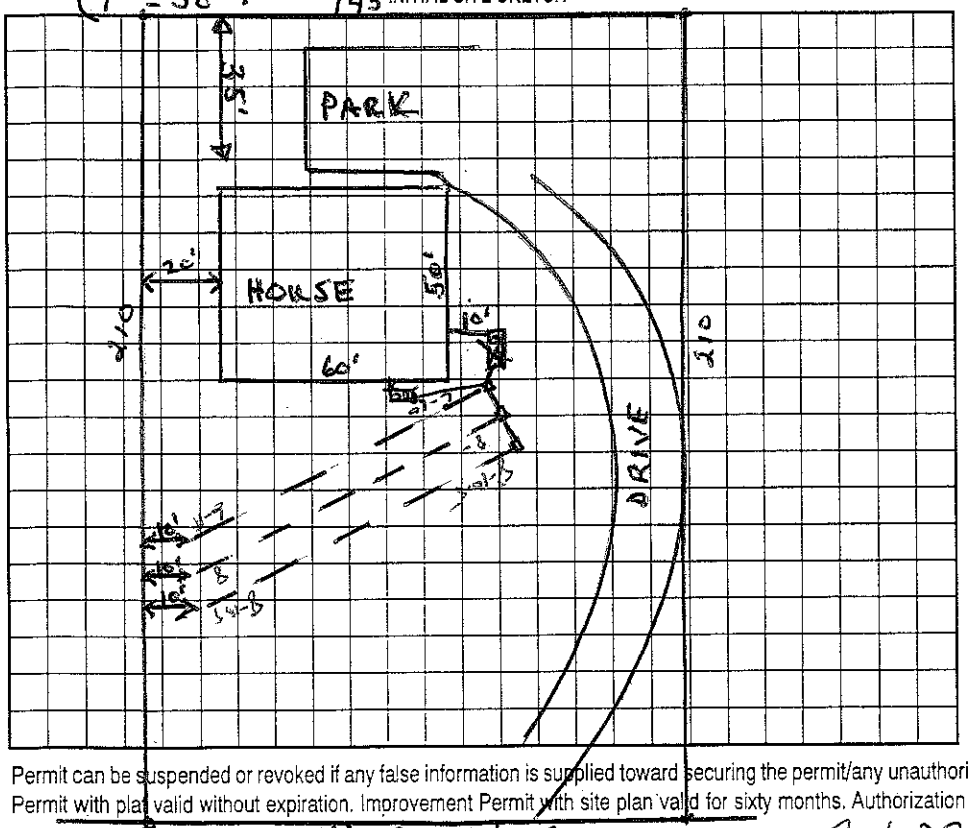

AS BUILT SKETCH

Permit can be suspended or revoked if any false information is supplied toward securing the permit/any unauthorized changes are made to the site/any unauthorized changes are made in the installation of the system. Improvement Permit with plat valid without expiration. Improvement Permit with site plan valid for sixty months. Authorization to Construct is valid for a period equal to that of Improvement Permit – not to exceed sixty months.

Signed: Howard Neal date 2-1-02 Installed by: F J Erwin

Improvement Permit by: Wesley Sparks RS. date 2/1/02 Operation Permit by: Wesley Sparks RS. date 11/6/02

Authorization to Construct by: Wesley Sparks RS. date 2/1/02 Existing System Inspection by: _____ date _____

HEALTH DEPT. COPY: WHITE OWNER COPY (FINAL): YELLOW OWNER COPY (INITIAL): PINK