IREDELL COUNTY HEALTH DEPARTMENT

STATESVILLE 704-878-5305 #130 MOORESVILLE 704-664-5281

IMPROVEMENT PERMIT / AUTHORIZATION TO CONSTRUCT / OPERATION PERMIT / EXISTING SYSTEM INSPECTION

PERMIT# 105374 PIN# 4636 96 7814

OWNER OR CONTRACTOR White Park Co. (Tegland, Brown) DATE 4/12/02

ADDRESS 7502 Windaliere Cornelius, NC 28031 PHONE: Business 704-895-9652 Home

LOCATION 1100 TL Canvasback TL Turnberry to 7th lot on (R)

SUBDIVISION St Andrews Village BLOCK / SECTION LOT 27 LOT AREA ~.52 SITE CLASS. PS DESIGN FLOW 360 L.T.A.R. .3

Septic Tank: 1000 Gallons; STB 1012 Date 5/24/02

Pump Tank: Gallons; PT Date

Pump Make: Model Serial No.

Nitrification Field: No Fields 1 Square Feet 900 * Linear Feet 300 *

No Lines 3 @ 100' Trench Width 3' Max Trench Bottom Depth 36" Gravel Depth No

☒ New System ☐ Repair System Type: I, II, (III), IV, V, VI

System Description: GR - EZLAY - CH. PLASTIC

Repair System Description: GR - 16" PPBPS

Maintenance Agreement Required: ☐ Yes ☒ No

☒ House/Mod. Home No. Bedrooms 3

☐ Mobile Home No. Bathrooms 2

☐ Business No. Employees

☐ Other


Water Supply: ☒ Individual ☐ Public ☒ Community

☐ Slab ☒ Crawl Space ☐ Basement w/plumbing ☐ Basement wo/plumbing


Comments:/Conditions:

Comments:/Conditions:

INITIAL SITE SKETCH

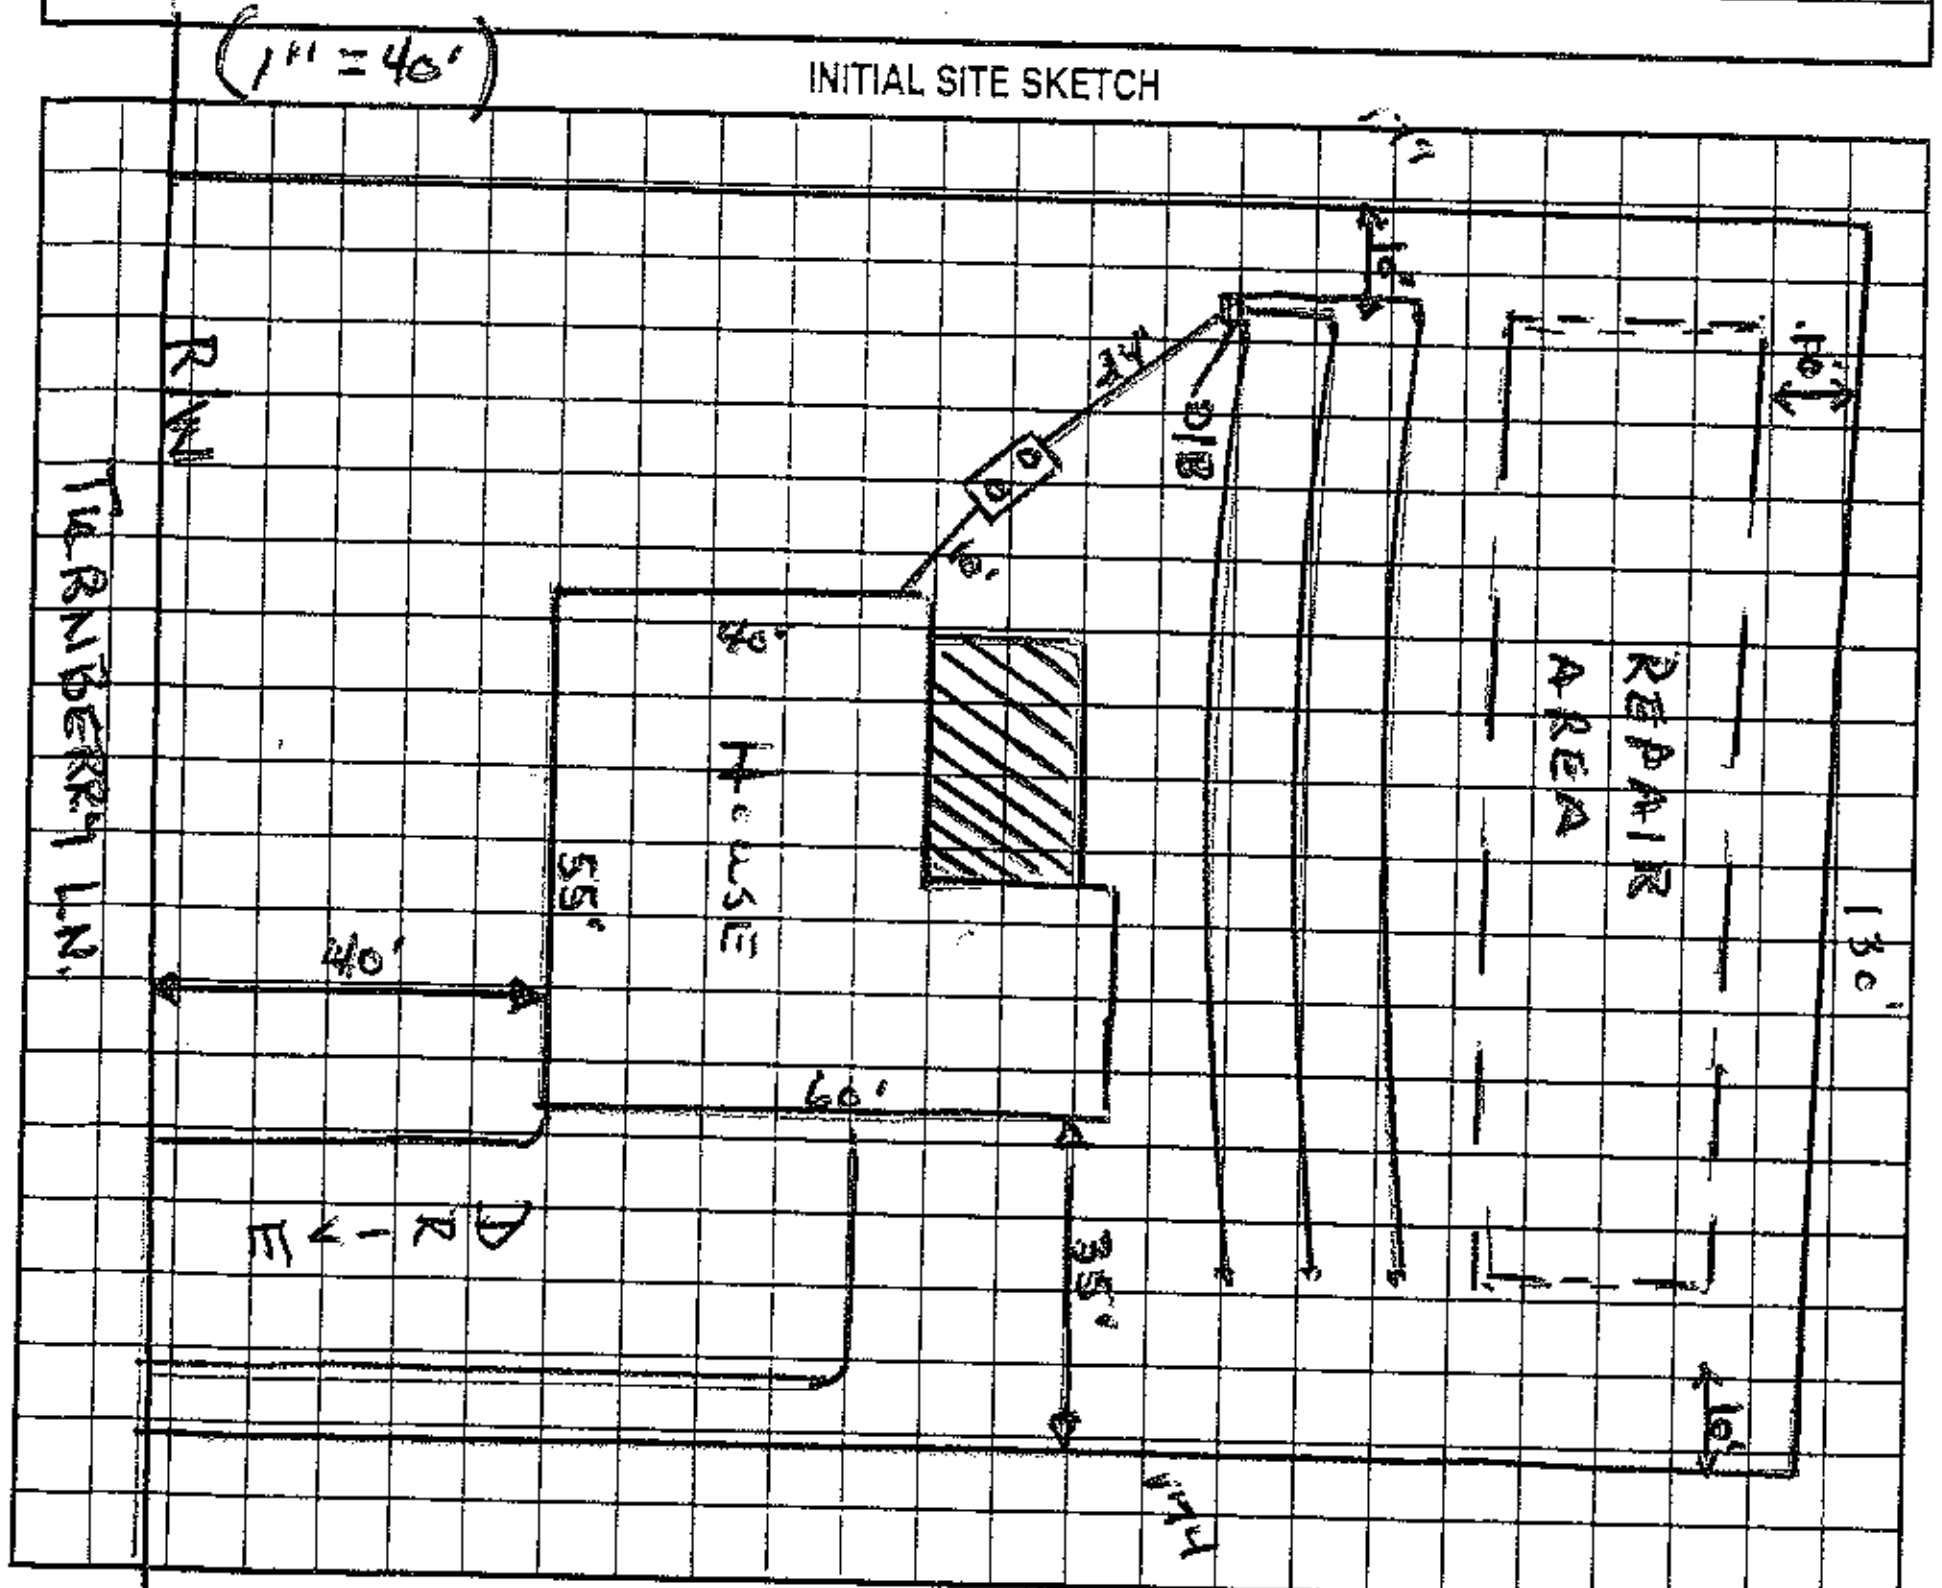

AS BUILT SKETCH

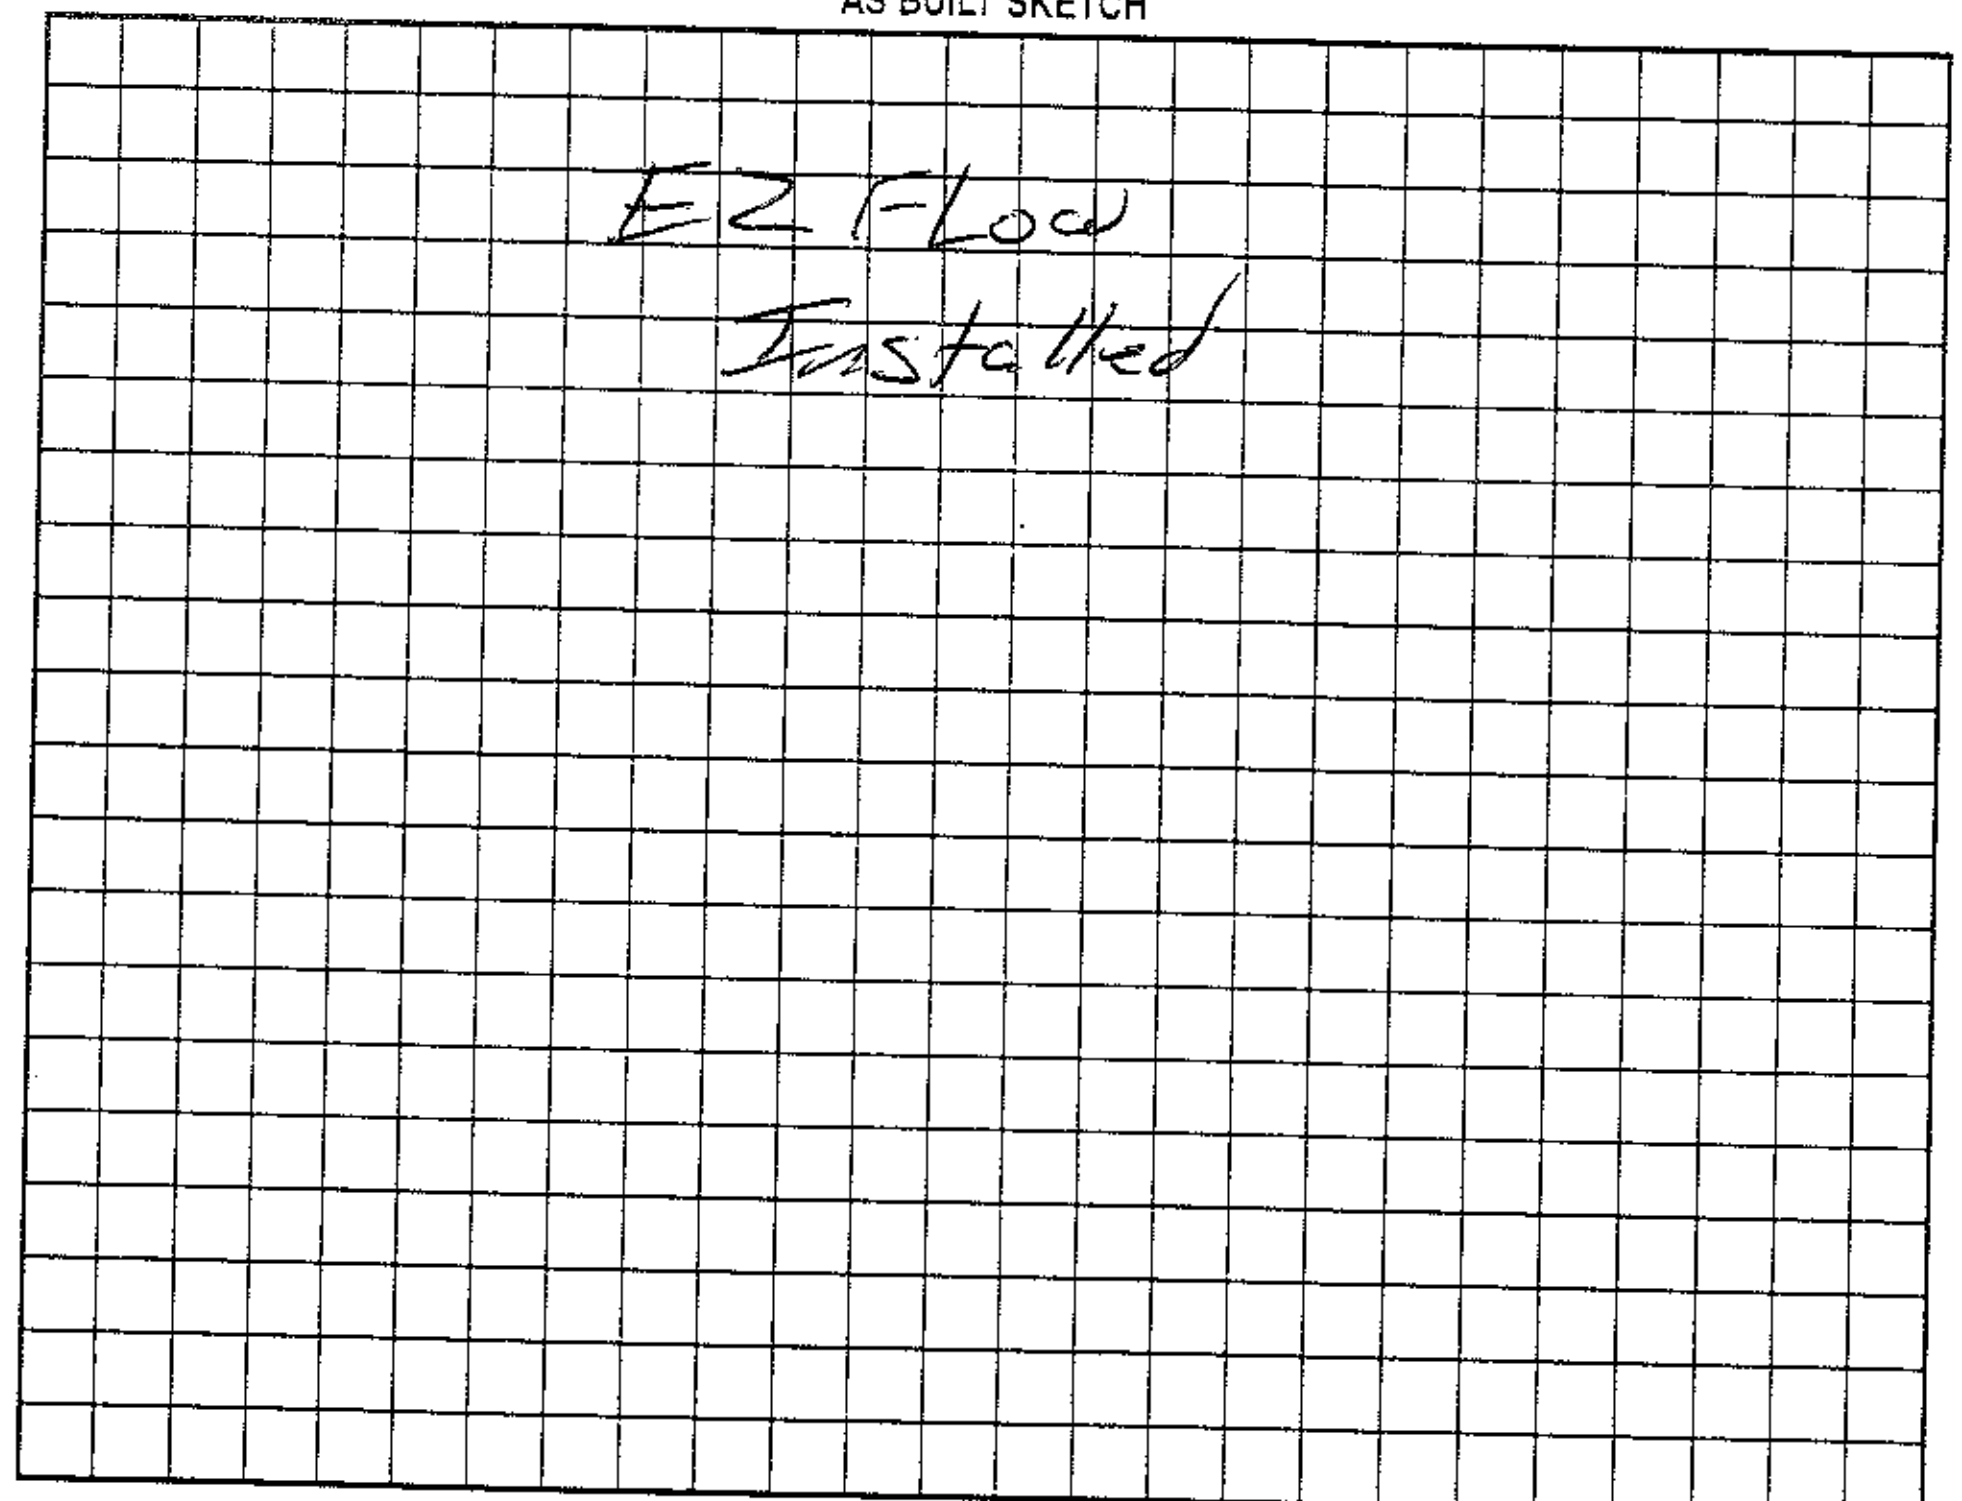

Permit can be suspended or revoked if any false information is supplied toward securing the permit/any unauthorized changes are made to the site/any unauthorized changes are made in the installation of the system. Improvement Permit with plat valid without expiration. Improvement Permit with site plan valid for sixty months. Authorization to Construct is valid for a period equal to that of Improvement Permit – not to exceed sixty months.

Signed: * Mike Tegland date 4/16/02 Installed by: Richard Abernethy

Improvement Permit by: Wesley Sparks R.S. date 4/12/02 Operation Permit by: [signature] RS date 7/24/02

Authorization to Construct by: Wesley Sparks R.S. date 4/12/02 Existing System Inspection by: date

HEALTH DEPT. COPY: WHITE OWNER COPY (FINAL): YELLOW OWNER COPY (INITIAL): PINK