IREDELL COUNTY HEALTH D... Statesville to Cantrell 4163697 2295

STATESVILLE 704-878-5305 MOORESVILLE 704-664-5281

IMPROVEMENT PERMIT / ~~CERTIFICATE OF COMPLETION~~ / OPERATION PERMIT / EXISTING SYSTEM INSPECTION

PROPERTY DESCRIPTION NO. 22234 DATE 10/19/95 TAX MAP NO. 2K 18A 4 Watershed: ☒ Yes ☐ No

OWNER OR CONTRACTOR Tim Ferguson & Heffner PHONE: Business 704-588-4150 710 Home 704-849-2257

ADDRESS 1059 D Crescent Dr. Charlotte, NC 28105

LOCATION Lot 4 St. Andrews Village, Conover Beck TL Turn by to the left on D

SUBDIVISION ST ANDREWS BLOCK / SECTION ____ LOT 4 LOT AREA ____ SITE CLASS. ____ DESIGN FLOW 360 L.T.A.R. .3

Septic Tank: 1000 Gallons; STB 794 Date 10/3/94

Pump Tank: ____ Gallons; PT ____ Date ____

Pump Make: ____ Model ____ Serial No. ____

Nitrification Field: No Fields 1 Square Feet 1200 Linear Feet ~~350~~ (400)

No Lines 4@15 Trench Width 36" Max Trench Bottom Depth 36" Gravel Depth N/A

☒ New System ☐ Repair System Type: I, II, III, IV, V, VI

System Description: GRAVITY INFILTRATOR

Repair System Description: SAME

Maintenance Agreement Required: ☐ Yes ☐ No

☒ House/Mod. Home No. Bedrooms 3

☐ Mobile Home No. Bathrooms 3

☐ Business No. Employees ____

☐ Other ____


☐ Slab ☒ Crawl Space ☐ Basement w/plumbing ☐ Basement wo/plumbing

Water Supply: ☐ Individual ☒ Community ☐ Public

Comments:

Comments: installed as shown.

INITIAL SITE SKETCH

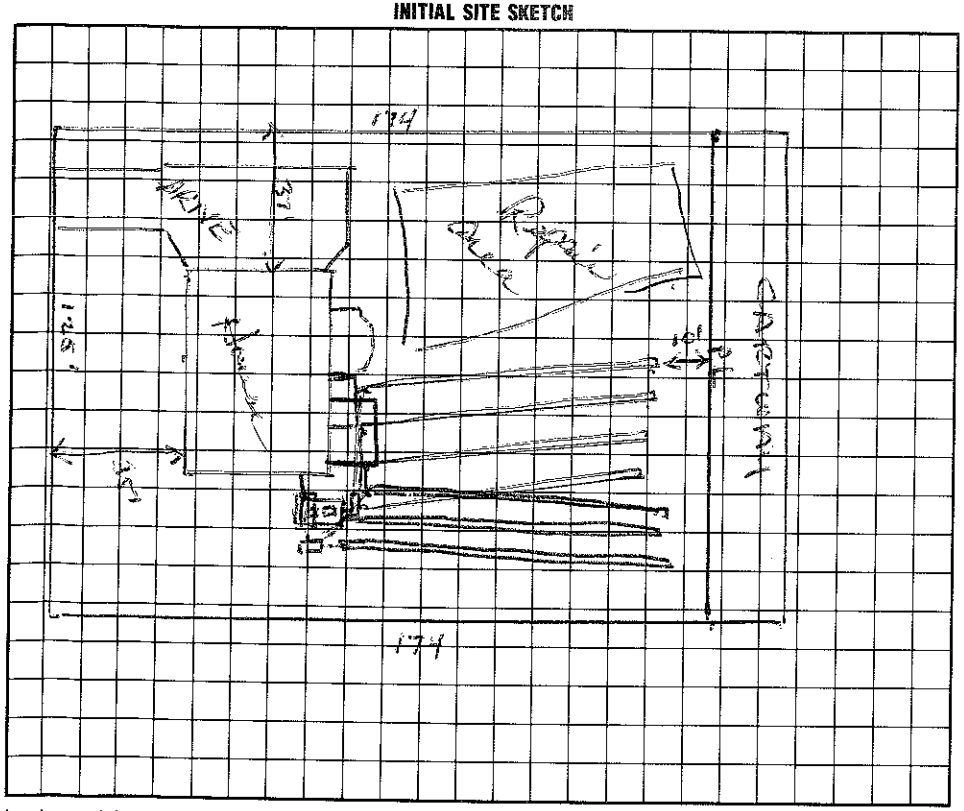

AS BUILT SKETCH

I understand that this permit can be suspended or revoked if any false information is supplied toward securing the permit/any unauthorized changes are made to the site/any unauthorized changes are made in the installation of the system.

Signed: [signature]

Improvement Permit by: Wesley Sparks R.S. date 10/17/95

~~ting System Inspection by:~~ Wesley Sparks R.S. date 10/17/95

Installed by: E J Crum

Certificate of Completion by: Wesley Sparks R.S. date 12/22/95

Operation Permit by: Wesley Sparks R.S. date 12/22/95

HEALTH DEPT. COPY: WHITE INSPECTION COPY (FINAL): GREEN OWNER COPY (FINAL): YELLOW INSPECTION COPY (INITIAL): PINK OWNER COPY (INITIAL): GOLD