IREDELL COUNTY HEALTH DEPARTMENT

STATESVILLE 704-878-5305 MOORESVILLE 704-664-5281

130

IMPROVEMENT PERMIT / AUTHORIZATION TO CONSTRUCT / OPERATION PERMIT / EXISTING SYSTEM INSPECTION

PERMIT# 119304 PIN# ~~4636-97-2726~~ 4646-16-1460 DATE 3/24/04

OWNER OR CONTRACTOR Heritage Homes of the Carolinas, Inc PHONE: Business 704-663-2710 Home

ADDRESS PO Box 3333 Mooresville NC 28117

LOCATION BSR, TL Canvasback, TL 1st Woodduck Lp, on Rd.

SUBDIVISION Lakeside Farm BLOCK / SECTION LOT 29 LOT AREA 17,451 Ft² SITE CLASS. PS DESIGN FLOW 480 L.T.A.R. 0.3

Septic Tank: 1000 Gallons: STB 350 Date 9/14/04
Pump Tank: Gallons: PT Date
Pump Make: Model Serial No.
Nitrification Field: No Fields 1 Square Feet 810 Linear Feet 270
No Lines 5@54' Trench Width 24" Max Trench Bottom Depth 36" Gravel Depth —

☒ New System ☐ Repair System Type: I, II, (III), IV, V, VI
System Description: Gravity Panel Block
Repair System Description: LPP Panel Block *
Maintenance Agreement Required: ☐ Yes ☒ No


☒ House/Mod. Home No. Bedrooms 4
☐ Mobile Home No. Bathrooms 3
☐ Business No. Employees
☐ Other
☐ Slab ☒ Crawl Space ☐ Basement w/plumbing ☐ Basement wo/plumbing

Water Supply:
☐ Individual
☐ Public
☒ Community


Comments:/Conditions:

Comments:/Conditions: * Dead Prior to 1983 - Docs not need 100% Repair Area

INITIAL SITE SKETCH

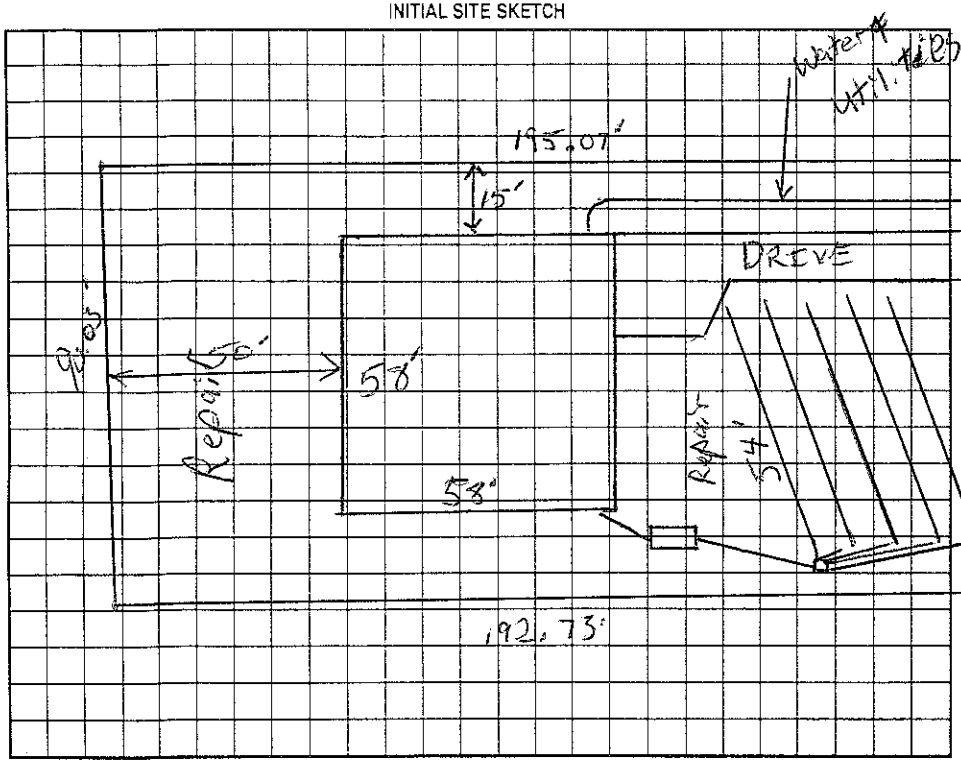

AS BUILT SKETCH

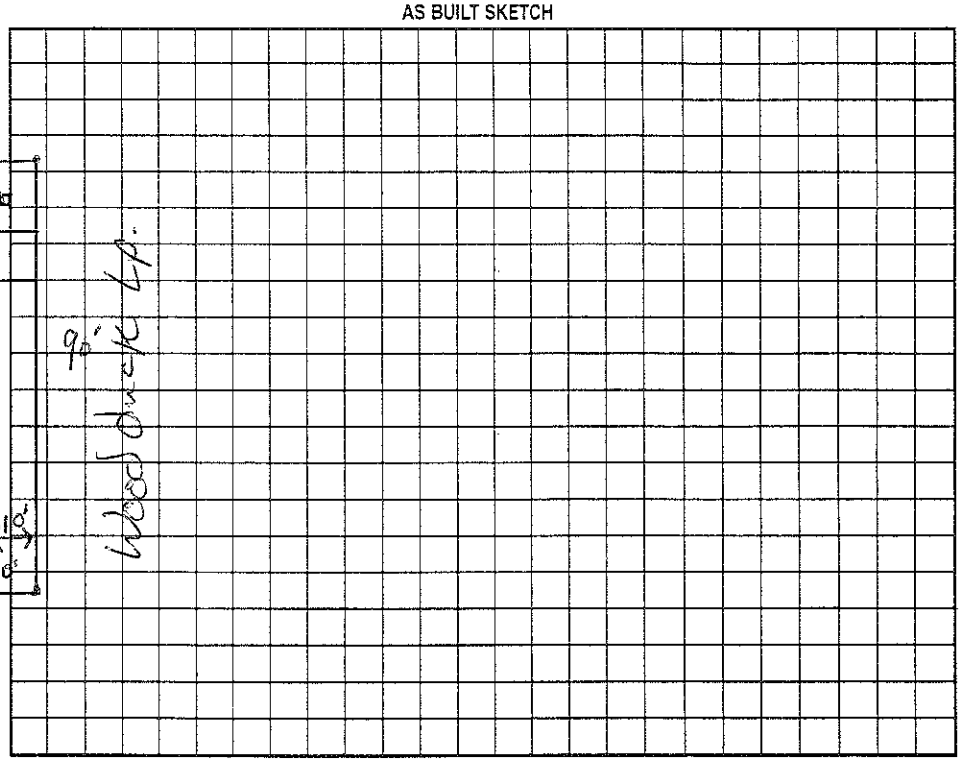

Permit can be suspended or revoked if any false information is supplied toward securing the permit/any unauthorized changes are made to the site/any unauthorized changes are made in the installation of the system. Improvement Permit with plat valid without expiration. Improvement Permit with site plan valid for sixty months. Authorization to Construct is valid for a period equal to that of Improvement Permit – not to exceed sixty months.

Signed: [signature] date 4-27-04 Installed by: Piedmont Septic

Improvement Permit by: [signature] RS date 3/24/04 Operation Permit by: [signature] RS date 12/3/04

Authorization to Construct by: [signature] RS date 3/24/04 Existing System Inspection by: date

HEALTH DEPT. COPY: WHITE OWNER COPY (FINAL): YELLOW OWNER COPY (INITIAL): PINK