IREDELL COUNTY HEALTH DEPARTMENT

STATESVILLE 704-878-5305 MOORESVILLE 704-664-5281

1:30

IMPROVEMENT PERMIT / AUTHORIZATION TO CONSTRUCT / OPERATION PERMIT / EXISTING SYSTEM INSPECTION

PERMIT# 109 403 PIN# 4636 - 97 - 3060 DATE 3/31/03

OWNER OR CONTRACTOR Tegland - Brown Const PHONE: Business 704-301-1644 Home

ADDRESS 7502 Windalire Cornelius NC 28031

LOCATION Brawley sch, TL Conway back, TL Turnberry on Rt

SUBDIVISION St. Andrews Village BLOCK / SECTION LOT 30 LOT AREA 0.52 Ac SITE CLASS. PS DESIGN FLOW 360 L.T.A.R. 0.3

Septic Tank: 1000 Gallons; STB 312 Date 2-12-03
Pump Tank: Gallons; PT Date
Pump Make: Model Serial No.
Nitrification Field: No Fields 1 Square Feet 600 Linear Feet 200
No Lines 4@50' Trench Width 24" or 36" Max Trench Bottom Depth 36" Gravel Depth —

☒ New System ☐ Repair System Type: I, II, (III), IV, V, VI
System Description: Gravity Panel Block
Repair System Description: LPP Panel Block
Maintenance Agreement Required: ☐ Yes ☒ No


☒ House/Mod. Home No. Bedrooms 3
☐ Mobile Home No. Bathrooms 2
☐ Business No. Employees
☐ Other
☐ Slab ☒ Crawl Space ☐ Basement w/plumbing ☐ Basement wo/plumbing

Water Supply:
☐ Individual
☐ Public
☒ Community

Comments:/Conditions:

Comments:/Conditions: Filter installed & Tank Marker installed Speed levelers used

INITIAL SITE SKETCH

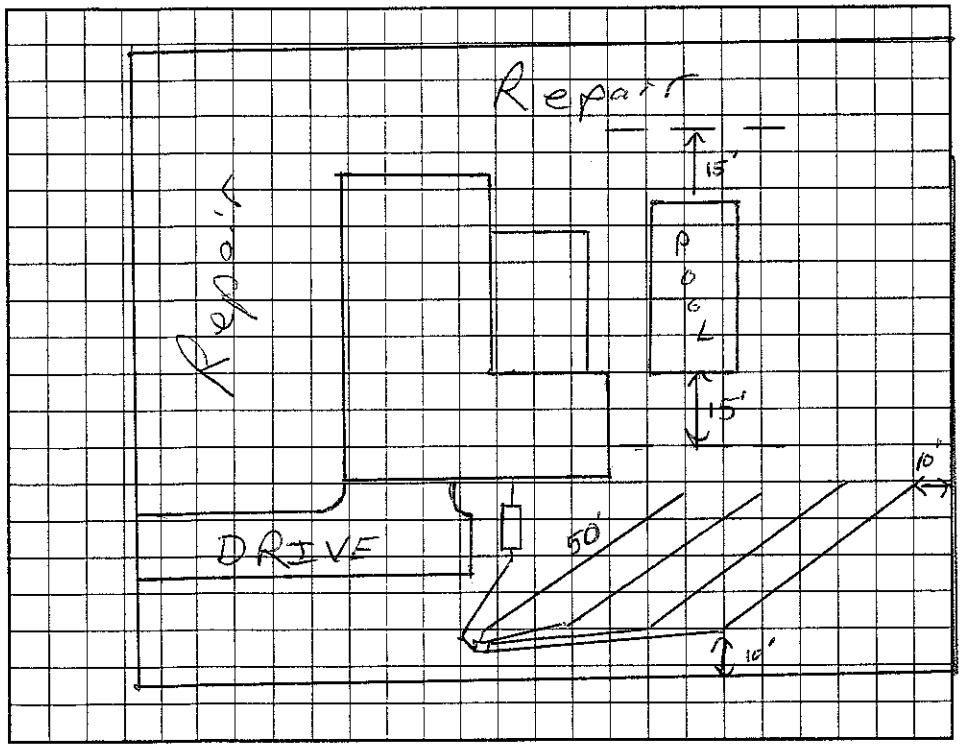

AS BUILT SKETCH

Installed as Drawn

Permit can be suspended or revoked if any false information is supplied toward securing the permit/any unauthorized changes are made to the site/any unauthorized changes are made in the installation of the system. Improvement Permit with plat valid without expiration. Improvement Permit with site plan valid for sixty months. Authorization to Construct is valid for a period equal to that of Improvement Permit – not to exceed sixty months.

Signed: Mike Tegland date 4/1/03 Installed by: Richard Abernathy RS

Improvement Permit by: [signature] RS date 3/31/03 Operation Permit by: Maintained by Dolan date 4/17/03

Authorization to Construct by: [signature] RS date 3/31/03 Existing System Inspection by: date

HEALTH DEPT. COPY: WHITE OWNER COPY (FINAL): YELLOW OWNER COPY (INITIAL): PINK