IREDELL COUNTY HEALTH DEPARTMENT - *ENVIRONMENTAL HEALTH* ☐ STATESVILLE OFFICE 704-878-5305 ☑ MOORESVILLE OFFICE 704-664-5281

IMPROVEMENT PERMIT / AUTHORIZATION TO CONSTRUCT / OPERATION PERMIT / EXISTING SYSTEM INSPECTION

cm

PERMIT # 72368 PIN # 4636-97-3712 DATE 5-16-12

OWNER GRANDE HOMES APPLICANT: SAME PHONE: Home/Cell # 704-895-1379 Business #

SITE ADDRESS 000 WOODDUCK LP OWNER / APPLICANT ADDRESS 555 DELBURG ST. DAVIDSON

SITE DIRECTIONS BSR, CANVASBACK, WOODDUCK, ON R

SUBDIVISION LAKESIDE FARM BLOCK / SECTION LOT # 28 LOT AREA .405 AC DESIGN FLOW 480 GPD L.T.A.R. .35/.3R

Septic Tank 1000 Gallons: STB 312 Date 6-30-12

Pump Tank Gallons: P T Date

Pump Make Model Serial #

No. Nitrification Fields: 1 No. Lines 6 Linear Feet 342

Trench Width 36" Max. Trench Bottom Depth 28" Gravel Depth

☑ New System ☐ Repair ☐ Expansion System Type I II (III) IV V VI

System Description: GRAVITY 25%

Repair System Description: PANEL BLOCK

Maintenance Agreement Required ☐ YES ☑ NO

☑ GRAVITY ☐ PRESSURE

☑ Residence No. Bedrooms 4

☐ Business No. Persons

☐ Other No. Employees


☐ Slab ☑ Crawl Space

☐ Basement w/plumbing ☐ Basement w/o plumbing

Water Supply: ☐ Private ☐ Public ☑ Community

Comments / Conditions ① HOUSE NEEDS TO BE 85' FROM RD

INITIAL SITE SKETCH

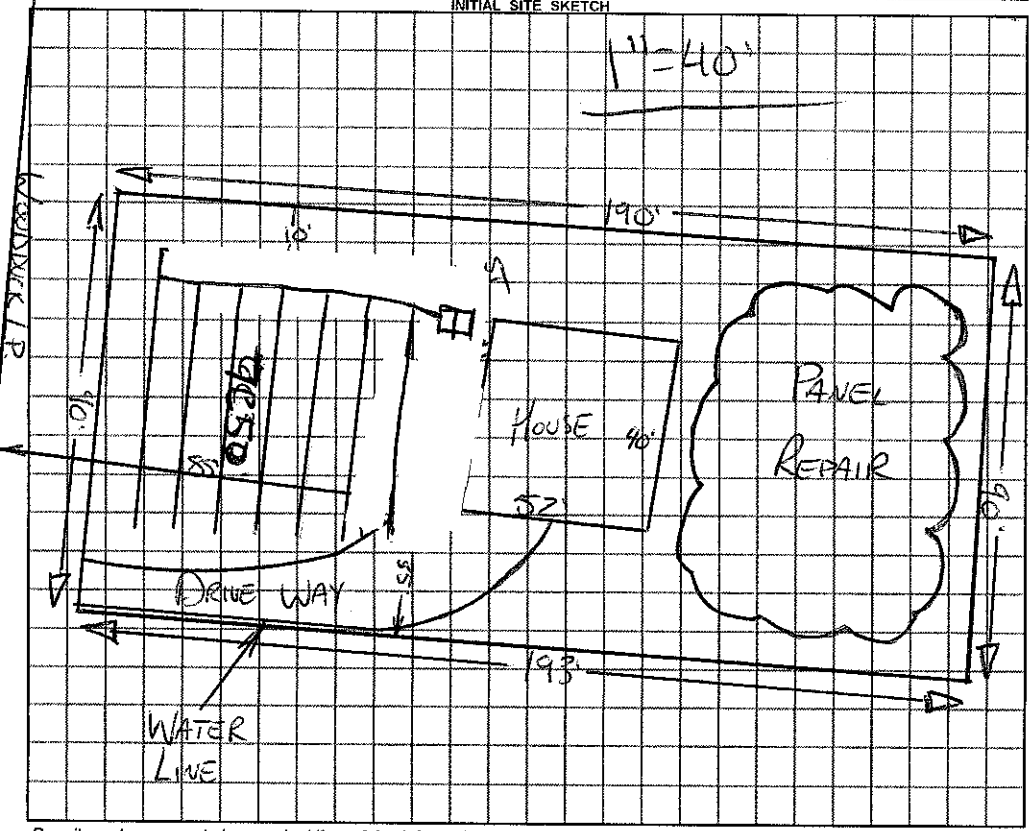

AS BUILT SKETCH

INSTALLED 7C50' QUIK 4

Permit can be suspended or revoked if any false information is supplied toward securing the permit / any unauthorized changes are made to the site / any unauthorized changes are made in the installation of the system.

☐ ***IMPROVEMENT PERMIT*** *with plat valid without expiration* ☑ ***IMPROVEMENT PERMIT*** *with ~~plat valid without expiration.~~ site plan valid 60 mo.* ☑ ***AUTHORIZATION TO CONSTRUCT*** valid for period equal to IMPROVEMENT PERMIT--not to exceed 60 mo.

Owner / Applicant Signature: Date 5-24-12

IMPROVEMENT PERMIT by: REHS Date 5-16-12

AUTHORIZATION TO CONSTRUCT by: REHS Date 5-24-12

YOU SHOULD CONTACT A LOCATOR SERVICE PRIOR TO ANY EXCAVATION

Installed by: TD LAWING GRADING

OPERATION PERMIT by: REHS Date 8-9-12

Existing System Inspected by: REHS Date

White Copy – Environmental Health YELLOW COPY (Final) Owner / Applicant PINK COPY (Initial) Owner / Applicant